

21-90000.00
21-90010.00
4587

FALL CREEK REGIONAL WASTE DISTRICT

9378 S 650 WEST, P.O. BOX 59, PENDLETON, IN 46064

765-778-7544

AGREEMENT FOR SANITARY SEWER SERVICE

This Agreement made and entered into this 24th day of May, 2002, between FALL CREEK REGIONAL WASTE DISTRICT ("District") and South Madison (Maple Ridge) (Applicant") regarding the provision of sanitary sewer service, and the assignment of capacity in, and connection to, the District's facilities for the premises located at 8537 S 650 W.

NOW THEREFORE, the parties, in consideration of the mutual promises set out in this Agreement, the receipt and sufficiency of which is hereby acknowledged, agree as follows:

1. The Applicant agrees that all workmanship and materials shall conform to all District ordinances and the District's construction standards. District must accept and approve all work and materials before backfilling and final connection is made to the sewer mains. Any violation of this provision will cause all lines and appurtenances in violation to be removed and replaced at the Applicant's expense.
2. The District shall have the right to enter upon the Applicant's premises at all reasonable times to inspect, repair, or replace any equipment used in connection with the District's service or which has an impact on said service.
3. The Applicant shall be responsible for all monthly user rates, capacity charges, and tap fees. The failure to pay any rate charge or fee may result in a lien against the property and/or the termination of service to the property, the cost of which will be borne by Applicant, including, but not limited to, all attorney's fees and collection costs.
4. The District shall not be responsible for any damages as a result of any failure to supply service unless said damages are due to default, neglect or culpability on the part of the District.
5. If there is an available sanitary sewer within three hundred (300) feet of the property line, the property owner shall be required to connect to the District's sanitary sewer system.
6. The Applicant and District agree that the provision of sanitary sewer service touches and concerns the property and the terms of this Agreement bind the District and Applicant and their heirs, executors, administrators, personal representatives, successors, agents, attorneys, assigns, designees, and transferees.

The parties hereto have read and fully understand the above provisions and agree to comply with said provisions.

FALL CREEK REGIONAL WASTE DISTRICT

Signature

STATE OF INDIANA)

) SS:

COUNTY OF MADISON)

APPLICANT

Signature

SUBSCRIBED and sworn to before me this _____ day of _____, 200____.

My Commission Expires:

Signature

Printed

Notary Public
Resident of Madison County

INSPECTOR Ti DATE INSPECTED 8/6/02 APPROVED / REJECTED _____

REASON FOR REJECTION _____

DATE REINSPECTED _____ APPROVED _____ REJECTED _____

NOTES:

SIZE PIPE 4" TYPE PIPE SD21

BASEMENT YES _____ NO _____

SUMP PUMP YES / NO _____

DOWNSPOUT TO GROUND YES / NO _____


SEPTIC TANK PUMPED & FILLED YES _____ NO _____

CONTRACTOR Boyer

SPECIAL CONDITIONS School

EXISTING HOME _____

NEW CONSTRUCTION /

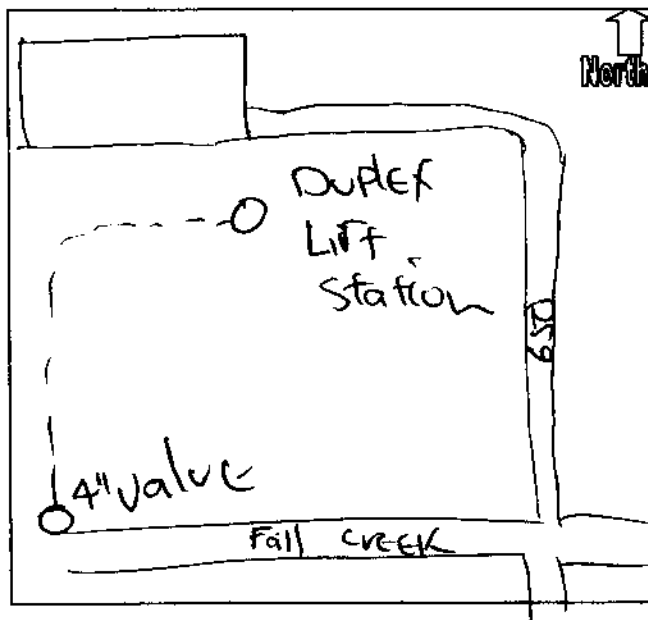



First Merchants Bank
First Merchants Bank, N.A. Muncie, Indiana

PAYEE:
FALL CREEK REGIONAL WASTE DISTRICT

ACCOUNT #/NAME:
71 00 5703 5P 5
SMC CONST/F 2001

SS#

DESCRIPTION:
TAP/CAPACITY FEE - PROJECT SM ELM SCH

CHECK #: 1896357
DATE: May 23, 2002
AMOUNT: \$59,474.00

NON-NEGOTIABLE

ORIGINAL CHECK HAS AN ARTIFICIAL WATERMARK ON REVERSE SIDE - HOLD AT AN ANGLE TO VIEW



First Merchants Bank
First Merchants Bank, N.A. Muncie, Indiana

ACCOUNT #/NAME:
71 00 5703 5P 5 SMC CONST/F 2001

DATE
May 23, 2002

71-65
749
1896357

PAY
FIFTY NINE THOUSAND FOUR HUNDRED SEVENTY FOUR AND 00/100
AMOUNT
*****\$59,474.00

TO THE ORDER OF FALL CREEK REGIONAL WASTE DISTRICT
9378 S 650 W
BOX 59
PENDLETON IN 46064-9566


AUTHORIZED SIGNATURE

