

26-65885.00

FALL CREEK REGIONAL WASTE DISTRICT

No 6409

9378 S 650 WEST, P.O. BOX 59, PENDLETON, IN 46064
765-778-7544

AGREEMENT FOR SANITARY SEWER SERVICE

COPY

This Agreement made and entered into this 8th day of December, 2010, between FALL CREEK REGIONAL WASTE DISTRICT ("District") and James W Flood ("Applicant") regarding the provision of sanitary sewer service, and the assignment of capacity in, and connection to, the District's facilities for the premises located at 8549 W 10005, Fortville
46046-9242

NOW THEREFORE, the parties, in consideration of the mutual promises set out in this Agreement, the receipt and sufficiency of which is hereby acknowledged, agree as follows:

1. The Applicant agrees that all workmanship and materials shall conform to all District ordinances and the District's construction standards. District must accept and approve all work and materials before backfilling and final connection is made to the sewer mains. Any violation of this provision will cause all lines and appurtenances in violation to be removed and replaced at the Applicant's expense.
2. The District shall have the right to enter upon the Applicant's premises at all reasonable times to inspect, repair, or replace any equipment used in connection with the District's service or which has an impact on said service.
3. The Applicant shall be responsible for all monthly user rates, capacity charges, and tap fees. The failure to pay any rate charge or fee may result in a lien against the property and/or the termination of service to the property, the cost of which will be borne by Applicant, including, but not limited to, all attorney's fees and collection costs.
4. The District shall not be responsible for any damages as a result of any failure to supply service unless said damages are due to default, neglect or culpability on the part of the District.
5. If there is an available sanitary sewer within three hundred (300) feet of the property line, the property owner shall be required to connect to the District's sanitary sewer system.
6. The Applicant and District agree that the provision of sanitary sewer service touches and concerns the property and the terms of this Agreement bind the District and Applicant and their heirs, executors, administrators, personal representatives, successors, agents, attorneys, assigns, designees, and transferees.

The parties hereto have read and fully understand the above provisions and agree to comply with said provisions.

FALL CREEK REGIONAL WASTE DISTRICT
Teresa K. Hutton
Signature

APPLICANT
James W. Flood
Signature


STATE OF INDIANA)
) SS:
COUNTY OF MADISON)

SUBSCRIBED and sworn to before me this 6th day of December, 2010.
My Commission expires: April 19, 2016
A Resident of Madison County, Indiana
Teresa K. Hutton, Notary Public
Signature Teresa K. Hutton
Notary Public
Resident of Madison County

INSPECTOR Tim DATE INSPECTED 7/13/11 APPROVED ✓ REJECTED _____
REASON FOR REJECTION _____

DATE REINSPECTED _____ APPROVED _____ REJECTED _____

NOTES:
SIZE PIPE 4" 1 1/2" TYPE PIPE SDR35/class 160
BASEMENT YES ✓ NO _____
SUMP PUMP YES _____ NO ✓
DOWNSPOUT TO GROUND YES ✓ NO _____
SEPTIC TANK PUMPED & FILLED YES _____ NO _____
CONTRACTOR Fisk Sanitation
SPECIAL CONDITIONS Tone wire Yes
EXISTING HOME _____
NEW CONSTRUCTION ✓

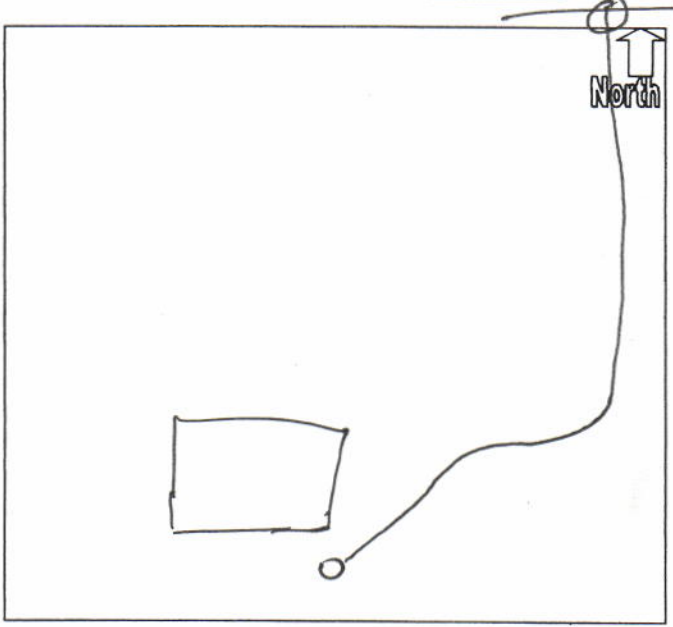

BILTRITE HOMES LLC

12542 MEETING HOUSE ROAD
CARMEL, IN 46032

HARRIS N.A.
71-1323-749

12/6/10

PAY TO THE
ORDER OF

Pay to the Cash Region Warehouse District \$ 3,370.00
Thirty Three Hundred Seventy 00 DOLLARS

MEMO

Flood

⑈002157⑈ ⑈074913233⑈

[Signature]
AUTHORIZED SIGNATURE



Security features. Details on back.

COPY

ORIGINAL DOCUMENT PRINTED ON CHEMICAL REACTIVE PAPER WITH MICROPRINTED BORDER - SEE REVERSE SIDE FOR COMPLETE SECURITY FEATURES

FISK SERVICES, INC.
271 S. FRANKLIN STREET
GREENFIELD, IN 46140
TELEPHONE: (317) 462-6626

REMITTANCE ADVICE					

71-367/749

5978

PAY

THE SUM 1660 DOLLARS 64 CTS

DOLLARS

DATE	TO THE ORDER OF	DESCRIPTION	CHECK NO.	NET AMOUNT
122210	FCRWD			1660 64

GREENFIELD BANKING CO.
GREENFIELD, IN 46140

[Signature]
AUTHORIZED SIGNATURE

THIS DOCUMENT CONTAINS HEAT SENSITIVE INK. TOUCH OR PRESS HERE - RED IMAGE DISAPPEARS WITH HEAT.

005978 074903670