



FALL CREEK REGIONAL WASTE DISTRICT

9378 S. 650 West PO Box 59
Pendleton, IN 46064-0059 778-7544

add order
on file

26-06610.00

APPLICATION FOR SEWER PERMIT

Nº 2955

Date 11-22-00

Permit Void 90 days from Date of Issuance

Owner Name Sean Hughes

Property Address 8577 Oldfort Rd

Lot # _____ P.O. Box _____

Town Fortville In, IN Zip Code 46040

Phone 485-5997 City Water _____ Well ✓

\$ _____ Tap on Fee Paid

\$ _____ Inspection fee paid

Application is hereby made for connection to the Fall Creek Regional Waste District Sewer System for the above listed property - Permit Type: Residential _____, Commercial _____, Industrial _____, or Governmental/Institutional _____. User Information _____.

All workmanship and materials shall conform to the standards of the District Ordinance as described in Ordinance 84-2 and 84-3 as amended. Acceptance and approval must be made by the District inspector or his duly authorized representative before backfilling and final connection is made to the main sewer lines. Any violation of applicable regulations will cause all lines and appurtenances in violation to be removed and replaced at the owners expense.

The Fall Creek Regional Waste District is responsible for the inspection, approval of materials, and installation techniques only. All costs for materials and installation and any liabilities resulting from same is the sole responsibility of the property owner.

I have read and fully understand the above provisions and agree to comply by said provisions.

Sean Hughes
APPLICANT(S) SIGNATURE

INSPECTOR P2

Date inspected 3-23-01 Approved ✓ Rejected _____

Reason for rejection _____

Date reinspected _____ Approved _____ Rejected _____

Notes:

Size Pipe 6 "

Type Pipe 35

Basement Yes _____ No ✓

Sump Pump Yes _____ No ✓

Downspout to Ground Yes ✓ No mandell


Septic Tank Pumped & filled Yes ✓ No _____

Contractor TACKSON

Special Conditions _____

Existing Home ✓

New Construction _____

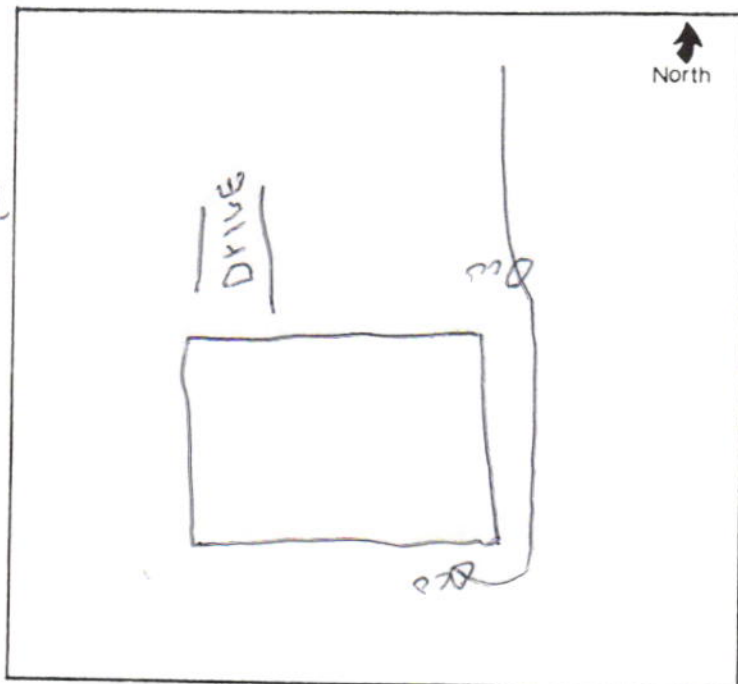

4162

765-778-7544

This Agreement made and entered into this 21st day of March, 2001, between FALL CREEK REGIONAL WASTE DISTRICT ("District") and Jean + Noel Hughes ("Applicant") regarding the provision of sanitary sewer service, and the assignment of capacity in, and connection to, the District's facilities for the premises located at 8577 Old Fort Road.

1. The Applicant agrees that all workmanship and materials shall conform to all District ordinances and the District's construction standards. District must accept and approve all work and materials before backfilling and final connection is made to the sewer mains. Any violation of this provision will cause all lines and appurtenances in violation to be removed and replaced at the Applicant's expense.

3. The Applicant shall be responsible for all monthly user rates, capacity charges, and tap fees. The failure to pay any rate charge or fee may result in a lien against the property and/or the termination of service to the property, the cost of which will be borne by Applicant, including, but not limited to, all attorney's fees and collection costs.

5. If there is an available sanitary sewer within three hundred (300) feet of the property line, the property owner shall be required to connect to the District's sanitary sewer system.

The parties hereto have read and fully understand the above provisions and agree to comply with said provisions.

APPLICANT Sean Hughes
Signature

SUBSCRIBED and sworn to before me this _____ day of _____, 200_____.

Signature _____

Notary Public
Resident of Madison County

REASON FOR REJECTION

DATE REINSPECTED	APPROVED	REJECTED
------------------	----------	----------

BASEMENT YES NO

SUMP PUMP YES _____ NO _____

DOWNPOUT TO GROUND YES NO

SEPTIC TANK PUMPED & FILLED YES NO

CONTRACTOR _____

SPECIAL CONDITIONS

EXISTING HOME

NEW CONSTRUCTION

