#7105

Fall Creek Regional Waste District 9378 S 650 W, P.O. Box 59, Pendleton, IN 46064 765-778-7544 Agreement for Sanitary Sewer Service

This Agreement made and entered into this K day of	
Regional Waste District ("District") and Turk Tenus provision of sanitary sewer service, and the assignment of capa	("Applicant") regarding the
facilities for the premises located at	city in and connection to, the District's
Street Address: 8601 Journes Jan Penal	Letry Del Wooley
Now therefore, the parties, in consideration of the mutual receipt and sufficiency of which is hereby acknowledged, agree	promises set out in this Agreement, the as follows:
 The Applicant agrees that all workmanship and materials shall conform to all District ordinances and the District's construction standards. District must accept and approve all work and materials before backfilling and final connection is made to the sewer mains. Any violation of this provision will cause all lines and appurtenances in violation to be removed and replaced at the Applicant's expense. The District shall have the right to enter upon the Applicant's premises at all reasonable times to inspect, repair, or replace any equipment used in connection with the District's service or which has an impact on said service. The Applicant shall be responsible for all monthly user rates, capacity charges, and tap fees. The failure to pay any rate charge or fee may result in a lien against the property and/or the termination of service to the property, the cost of which will be borne by Applicant, including, but not limited to, all attorney's fees and collection costs. The District shall not be responsible for any damages as a result of any failure to supply service unless said damages are due to default, neglect or culpability on the part of the District. If there is an available sanitary sewer within three hundred (300) feet of the property line, the property owner shall be required to connect to the District's sanitary sewer system. The Applicant and District agree that the provision of sanitary sewer service touches and concerns the property and the terms of this Agreement bind the District and Applicant and their heirs, executors, administrators, personal representatives, successors, agents, attorneys, assigns, designees, and transferees. 	
The parties hereto have read and fully understand the above provisions.	e provisions and agree to comply with said
	APPLICANT)
FALL CREEK REGIONAL WASTE DISTRICT	APPLICANT
	APPLICANT Signature
FALL CREEK REGIONAL WASTE DISTRICT Signature STATE OF INDIANA	
FALL CREEK REGIONAL WASTE DISTRICT Signature	
FALL CREEK REGIONAL WASTE DISTRICT Signature STATE OF INDIANA) SS: COUNTY OF MADISON) SUBSCRIBED and sworn to before me this day of OFFICIAL SEAL My CommissionExpires ANDERSON NOTARY PUBLIC-STATE OF INDIANA MADISON COUNTY Signature Signature	Signature Actor 20 20 Colo E Hur
FALL CREEK REGIONAL WASTE DISTRICT Signature STATE OF INDIANA) SS: COUNTY OF MADISON) SUBSCRIBED and sworn to before me this day of OFFICIAL SEAL MY CommissionExpires ANDERSON NOTARY PUBLIC-STATE OF INDIANA MADISON COUNTY MY COMM. EXPIRES OCTOBER 23, 2021 Printed	
FALL CREEK REGIONAL WASTE DISTRICT Signature STATE OF INDIANA) SS: COUNTY OF MADISON) SUBSCRIBED and sworn to before me this day of OFFICIAL SEAL My Commission Expires ANDERSON NOTARY PUBLIC-STATE OF INDIANA MADISON COUNTY MY COMM. EXPIRES OCTOBER 23, 2021 NOTARY PUBLIC STATE OF INDIANA MADISON COUNTY MY COMM. EXPIRES OCTOBER 23, 2021 NOTARY PUBLIC STATE OF INDIANA MADISON COUNTY MY COMM. EXPIRES OCTOBER 23, 2021 NOTARY PUBLIC STATE OF INDIANA MADISON COUNTY MY COMM. EXPIRES OCTOBER 23, 2021 NOTARY PUBLIC STATE OF INDIANA MADISON COUNTY MY COMM. EXPIRES OCTOBER 23, 2021 NOTARY PUBLIC STATE OF INDIANA MADISON COUNTY MY COMM. EXPIRES OCTOBER 23, 2021	Signature Feb., 20 20 Ochel E. Hunanderson
FALL CREEK REGIONAL WASTE DISTRICT Signature STATE OF INDIANA) SS: COUNTY OF MADISON) SUBSCRIBED and sworn to before me this day of	Signature Signature Achel E. Judeson Otary Public esident of Madison County ***********************************
FALL CREEK REGIONAL WASTE DISTRICT Signature STATE OF INDIANA) SS: COUNTY OF MADISON) SUBSCRIBED and sworn to before me this day of OFFICIAL SEAL My Commission Expires ANDERSON NOTARY PUBLIC-STATE OF INDIANA MADISON COUNTY MY COMM. EXPIRES OCTOBER 23, 2021 Printed NO Re	Signature Signature And Support Stary Public Stary Public County Rejected
FALL CREEK REGIONAL WASTE DISTRICT Signature STATE OF INDIANA) SS: COUNTY OF MADISON) SUBSCRIBED and sworn to before me this day of OFFICIAL SEAL MY Commission Expires ANDERSON NOTARY PUBLIC-STATE OF INDIANA MADISON COUNTY MY COMM. EXPIRES OCTOBER 23, 2021 Printed NO Re *********************************	Signature Signature And Support Stary Public Stary Public County Rejected
FALL CREEK REGIONAL WASTE DISTRICT Signature STATE OF INDIANA) SS: COUNTY OF MADISON) SUBSCRIBED and sworn to before me this day of	Signature Signature And Support Stary Public Stary Public County Rejected
FALL CIREEK REGIONAL WASTE DISTRICT Signature STATE OF INDIANA) SS: COUNTY OF MADISON) SUBSCRIBED and sworn to before me this day of	Signature Signature And Support Stary Public Stary Public County Rejected
FALL CREEK REGIONAL WASTE DISTRICT Signature STATE OF INDIANA) SS: COUNTY OF MADISON) SUBSCRIBED and sworn to before me this day of	Signature Signature Abb. , 20 D Abb. E Hunder County Stary Public County Rejected Rejected Rejected
FAL CREEK REGIONAL WASTE DISTRICT Signature STATE OF INDIANA) SS: COUNTY OF MADISON) SUBSCRIBED and sworn to before me this day of	Signature Signature Abb. , 20 D Abb. E Hunder County Stary Public County Rejected Rejected Rejected
FALL CIREEK REGIONAL WASTE DISTRICT Signature STATE OF INDIANA) SS: COUNTY OF MADISON) SUBSCRIBED and sworn to before me this day of	Signature Signature Abb. , 20 D Abb. E Hunder County Stary Public County Rejected Rejected Rejected
FALL CREEK REGIONAL WASTE DISTRICT Signature STATE OF INDIANA) SS: COUNTY OF MADISON) SUBSCRIBED and sworn to before me this day of	Signature Signature Abb. , 20 D Abb. E Hunder County Stary Public County Rejected Rejected Rejected
FALL CIREEK REGIONAL WASTE DISTRICT Signature STATE OF INDIANA) SS: COUNTY OF MADISON) SUBSCRIBED and sworn to before me this day of	Signature Signature Abb. , 20 D Abb. E Hunder County Stary Public County Rejected Rejected Rejected

TOM TOWN



STOEPPELWERTH

ALWAYSOI

7965 East 106th Street, Fishers, IN 46038-2505 phone: 317.849.5935 fax: 317.849.5942

SEEDING TO BE INSTALLED DO NOT DISTURB. 50.1 54.00 49.3 S.S.D. RISER T.C.=850.10 ± 15 52.0 SEED TO HERE MODEL= BIRCH K F.F.ELEV.= 853.23 (SLAB) (LH) (VERSION 01) 51.9 51.9 00 00 LOT 23 40.00 VACANT LOT 119. 6 LOT 25 VACANT LOT GAR. 20. 51.4 51.2 852.90 32.00 SOD LINE 7.0 51.9 12.00 51.9 CONC. DRIVE POR 30 3'SW .00 B.S. - SOD LINE 20' D&U.E 31.0 APPROX. 15' FROM TAP TO HOUSE 35. 46.0' 50.7 50.9 54.00 5'SW Ζw R/W) **FOWNES** 50.25 50.65 LANE 52, 5'SW 5'SW COMMON AREA "C" VAR. D.U.&S.E. T.C.=851.04± =850.26±

253'±

JOB ID OAKMONT.24

CONTROL# 90486 RYAN



8601 FOWNES LANE PENDLETON, IN 46064

1" = 30'

LOT AREA: 6,426 Sq. Ft.

LOT 24 OAKMONT SECTION ONE

INST. #2019R002446

LEGEND:

XX.X

PROPOSED GRADE PER PLAN

XX.XAB

AS BUILT GRADE

S.S.D. SUB-SURFACE DRAIN
SANITARY SEWER
6" AS BUILT SANITARY LATERAL
PSL 6" PROPOSED SANITARY LATERAL
STORM SEWER
WATER MAIN
3/4" WATER CONNECTION
SWALE

SANITARY MANHOLE

STORM MANHOLE

CURB INLET

FIRE HYDRANT

END SECTION

₩ WATER VALVE

EMERGENCY FLOOD ROUTE

D.U.&S.E. DRAINAGE UTILITY & SEWER EASEMENT
B.L. BUILDING LINE.
D.E. DRAINAGE EASEMENT
D.&U.E. DRAINAGE & UTILITY EASEMENT

STOEPPELWEITH

No.

80040474

STATE OF

No.

STATE

NOTE: THIS DRAWING IS NOT INTENDED TO BE REPRESENTED AS A RETRACEMENT OR ORIGINAL BOUNDARY SURVEY, A ROUTE SURVEY OR A SURVEYOR LOCATION REPORT.



BENCHMARK
TOP OF CURB=850.65

ALL UNDERGROUND SEWERS AND UTILITIES SHOWN ARE PLOTTED BY SCALE FROM DESIGN PLANS FURNISHED BY ENGINEER THE ACTUAL FIELD LOCATION MAY VARY.





STOEPPELWERTH

ALWAYSON

7965 East 106th Street, Fishers, IN 46038-2505 phone: 317.849.5935 fax: 317.849.5942




JOB ID OAKMONT.24

CONTROL# 90486 RYAN

8601 FOWNES LANE PENDLETON, IN 46064

1" = 30'

LOT AREA: 6,426 Sq. Ft.

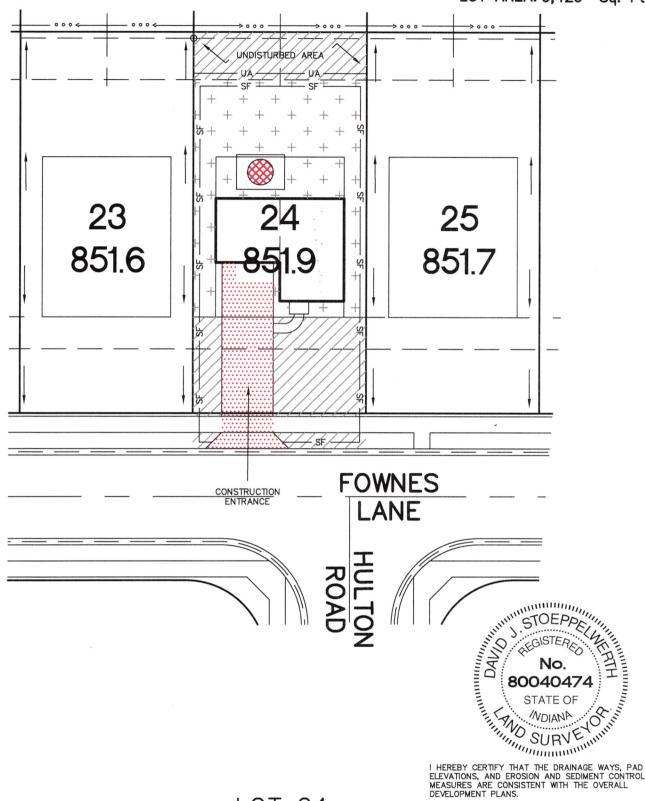

LOT 24
OAKMONT
SF SILT FENCE
UNDISTURBED AREA

SECTION ONE
INST. #2019R002446

30' MINIMUM FRONT YARD 15' MINIMUM REAR YARD 5' MINIMUM SIDE YARD 10' MINIMUM BETWEEN STRUCTURE David J. Stoeppelwerth

NOTE: THIS DRAWING IS NOT INTENDED TO BE REPRESENTED AS A RETRACEMENT OR ORIGINAL BOUNDARY SURVEY, A ROUTE SURVEY OR A SURVEYOR LOCATION REPORT.

DENOTES PERMANENT SEEDING & MULCHING AREAS

DENOTES SEEDING W/FIBER BLANKET

STONE CONSTRUCTION ENTRANCE



SOIL STOCKPILE

THIS LOT LIES IN ZONE: X

COMMUNITY PANEL: # 18095C0305 E

DATE: JUNE 9, 2014

RYAN HOMES 8425 WOODFIELD CROSSING BOULEVARD INDIANAPOLIS, IN 46240, SUITE 310W



LOT24

8601 Founes

7/13/20 wills ep

LOT 24


8601 Fownes

221/2

221/2



Bank of America, N.A. Atlanta, Dekalb County, Georgia

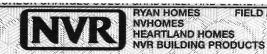

334629

02/11/20

VENDOR #

70075

334629

PAY

FIELD ACCOUNT

**3,370.00

EXACTLY:

THREE THOUSAND THREE HUNDRED SEVENTY DOLLARS AND 00 CENTS

PAY TO THE ORDER OF:

VOID AFTER 90 DAYS

NVR, INC.

CHECK NOT VALID OVER \$50,000.00

FALL CREEK REGIONAL WASTE

Pec + 011138

SECURITY FEATURES INCLUDED TO DETAILS ON BACK