#8394

Fall Creek Regional Waste District 9378 S 650 W, P.O. Box 59, Pendleton, IN 46064 765-778-7544

Agreement for Sanitary Sewer Service

This Agreement made and entered into this day of Regional Waste District ("District") and Lennar Homes provision of sanitary sewer service, and the assignment of capacifacilities for the premises located at Springbrook Lot 414	("Applicant") regarding the				
Street Address: 8418 Jripe Dd.	 -				
Now therefore, the parties, in consideration of the mutual preceipt and sufficiency of which is hereby acknowledged, agree					
 The Applicant agrees that all workmanship and materia and the District's construction standards. District must a before backfilling and final connection is made to the seprovision will cause all lines and appurtenances in violated Applicant's expense. The District shall have the right to enter upon the Applitinspect, repair, or replace any equipment used in connection an impact on said service. The Applicant shall be responsible for all monthly user failure to pay any rate charge or fee may result in a lient termination of service to the property, the cost of which but not limited to, all attorney's fees and collection cost. The District shall not be responsible for any damages as unless said damages are due to default, neglect or culpated. If there is an available sanitary sewer within three hund property owner shall be required to connect to the District. The Applicant and District agree that the provision of seconcerns the property and the terms of this Agreement I heirs, executors, administrators, personal representative designees, and transferees. 	accept and approve all work and materials ewer mains. Any violation of this ation to be removed and replaced at the acant's premises at all reasonable times to action with the District's service or which rates, capacity charges, and tap fees. The against the property and/or the will be borne by Applicant, including, as. Is a result of any failure to supply service bility on the part of the District. Ired (300) feet of the property line, the ict's sanitary sewer system. In anitary sewer service touches and bind the District and Applicant and their				
The parties hereto have read and fully understand the above provisions.	e provisions and agree to comply with said				
FATL CREEK REGIONAL WASTE DISTRICT Signature	APPLICANT Signature				
STATE OF INDIANA)) SS: COUNTY OF MADISON)					
SUBSCRIBED and sworn to before me this day of	, 20				
My Commission Expires: Signature					
Printed Notary Public Resident of County ***********************************					
Inspector Down Date Inspected 1-10-23 Approved Reason for Rejecton	Rejected				
Date Reinspected Approved Notes: Size Pipe Type Pipe W35	Rejected				
Basement <u>Yes No</u> Sump Pump <u>Yes No</u> Downspout to Ground <u>Yes No</u> Septic Tank Pumped & Filled <u>Yes No</u>	North				
Contractor DANNWY TO THE Special Conditions Existing Home New Construction	Drawing + 1 Picture				
TOW CONSTRUCTION	1 Picture attached				

STOEPPELWERTH

7965 East 106th Street, Fishers, IN 46038-2505

phone: 317.849.5935 fax: 317.849.5942

CONTROL# 107435 LEN

JOB ID SPRINGBK8.414

PARCEL#48-15-28-403-008.414-014

8618 TRIPP ROAD PENDLETON, IN 46064

1" = 30'

LOT AREA: 7,800 <u>Sq.</u> Ft. DESIGN PAD=863.5

AS-BUILT PAD=864.1 M.F.F.E.=864.2

M.F.P.G.=864.2

LEGEND: XX.X PROPOSED GRADE PER PLAN XX.XAB AS BUILT GRADE

S.S.D. _ - - SUB-SURFACE DRAIN SUB-SURFACE DRAIN
SANITARY SEWER
6" AS BUILT SANITARY LATERAL
6" PROPOSED SANITARY LATERAL
STORM SEWER ASL

W

W

3/4" WATER CONNECTION WATER MAIN **SWALE**

STORM MANHOLE

FIRE HYDRANT

SANITARY MANHOLE

CURB INLET

卷 STREET TREE

WATER METER

DRAINAGE & UTILITY EASEMENT BUILDING LINE MINIMUM FINISHED FLOOR D.&U.E. B.L. M.F.F.E. ELEVATION
MINIMUM FLOOD PROTECTION M.F.P.G.

GRADE

63.0AB T.C.=861.38 AS BUILT 60.00 10' D.&U.E. 44.6' 54.6 D.&U.E. 10, 10.00 PATIO 30.00 00 00 MODEL= BROADMOOR C F.F.ELEV.=864.99 (SLAB) (RH) 130. 30. 10.00 38. 21.04 GAR. 864.53 64.2AB 0 10.00 POR 30' B.L. 00 CONC. DRIVE 7 AB63.7 20. 20' D.&U.E. 31.0 D.S.=3.9% 60'± 180'± 8 20.0 AB62.9 60.00 5' SW 器 63.5AB \geq C. +862.31 AS BUILT 62.54 TRIPP 62.93 œ T.C.=862.40 ROAD 09 5' SW

PORCH/ENTRY DETAIL 1"=10" PORCH 2. 0.38 2.00 2.42' 6.58' 2.42

No. BOO40474
STATE OF
WDIANA ORIGINALITY
SURVENIENT
SUR

NOTE: THIS DRAWING IS FOR PERMITTING PURPOSES ONLY AND NOT INTENDED TO BE REPRESENTED AS A RETRACEMENT SURVEY, ORIGINAL SURVEY, ROUTE SURVEY, LOT SURVEY OR A SURVEYOR LOCATION REPORT OR ANY OTHER TYPE OF PROPERTY BOUNDARY ASSESSMENT. NO BOUNDARY CORNERS HAVE BEEN SET AND THEREFORE NO LIABILITY WILL BE ASSUMED FOR ANY USE OF THIS DATA FOR CONSTRUCTION OF NEW IMPROVEMENTS INCLUDING FENCES.

06/12/23 NSH

T.C.=863.18 ± T.C.=863.33±

BENCHMARK TOP OF CASTING=862.40

LOT 414 SPRINGBROOK SECTION 8

INST. #2023R006746 ZONING: R3

5' MINIMUM SIDE YARD 30' MINIMUM FRONT YARD

15' MINIMUM REAR YARD


ALL UNDERGROUND SEWERS AND UTILITIES SHOWN ARE PLOTTED BY SCALE FROM DESIGN PLANS FURNISHED BY ENGINEER THE ACTUAL FIELD LOCATION MAY VARY.

CONC. DRIVEWAY:
PRIVATE WALK:
PUBLIC WALK:
APRON:
ADDITIONAL SOD:
HANDICAP RAMPS:

643 ± N/A ± 861 ± 23 ± 200 ± 345 ± Sq. Yd. Sq. Ft. Sq. Ft. Sq. Ft. Sq. Ft. Sq. Ft. Sq. Yd.

SIGNATURE: DATE: SIGNATURE REPRESENTS CONFIRMATION OF RECEIPT OF PLOT PLAN BY CUSTOMER



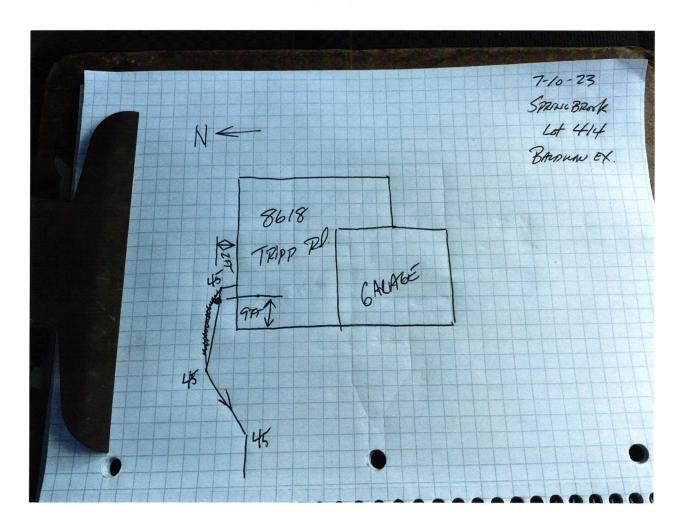



Lennar Corporation Lennar Homes of Indiana, LLC Indianapolis Division 11555 N Meridian St Ste 400 Carmel, IN 46032

C620426992042699

PAGE: 1 of 1

DATE: June 12, 2023 CHECK NUMBER: 2042699 AMOUNT PAID: \$760.00

OOOO8 P249 CKZ ZD 537P3 - OOO5045P44 NNNNNNNNNN 7P32700004503 XID3CP C FALL CREEK REGIONAL WASTE DISTRICT PO BOX 59 PENDLETON IN 46064



Vendor No: 12975753

Date	CO. #	Invoice Number	Payment Advice	Gross Amount	Discount	Net Amount
06/05/23	69365	69365710414 WS	MV-69365710414 WS	\$760.00	\$0.00	\$760.00
TOTALS			\$760.00	\$0.00	\$760.00	

Jac # 00530

PLEASE DETACH BEFORE DEPOSITING CHECK

Lennar Corporation Lennar Homes of Indiana, LLC Indianapolis Division 11555 N Meridian St Ste 400 Carmel, IN 46032

CHECK NUMBER

2042699

70-2322 719

June 12, 2023

*** VOID AFTER 180 DAYS ***

PAY

FALL CREEK REGIONAL WASTE DISTRICT

TO THE

PO BOX 59

ORDER OF:

PENDLETON, IN 46064

CHECK AMOUNT

\$760.00

EXACTLY ******760 DOLLARS AND 00 CENTS

JPMorgan Chase Bank, N.A. Chicago, IL

Authorized Signature