

Walters

22-39905.00

**Fall Creek Regional Waste District**  
9378 S 650 W, P.O. Box 59, Pendleton, IN 46064  
765-778-7544

#7327

**Agreement for Sanitary Sewer Service**

This Agreement made and entered into this 3 day of Sept., 2020 between Fall Creek Regional Waste District ("District") and Davis Building ("Applicant") regarding the provision of sanitary sewer service, and the assignment of capacity in and connection to, the District's facilities for the premises located at dot 108 E.C.

Street Address: 865 W. Baranck Pendleton, Ind 46064

**Now therefore**, the parties, in consideration of the mutual promises set out in this Agreement, the receipt and sufficiency of which is hereby acknowledged, agree as follows:

1. The Applicant agrees that all workmanship and materials shall conform to all District ordinances and the District's construction standards. District must accept and approve all work and materials before backfilling and final connection is made to the sewer mains. Any violation of this provision will cause all lines and appurtenances in violation to be removed and replaced at the Applicant's expense.
2. The District shall have the right to enter upon the Applicant's premises at all reasonable times to inspect, repair, or replace any equipment used in connection with the District's service or which has an impact on said service.
3. The Applicant shall be responsible for all monthly user rates, capacity charges, and tap fees. The failure to pay any rate charge or fee may result in a lien against the property and/or the termination of service to the property, the cost of which will be borne by Applicant, including, but not limited to, all attorney's fees and collection costs.
4. The District shall not be responsible for any damages as a result of any failure to supply service unless said damages are due to default, neglect or culpability on the part of the District.
5. If there is an available sanitary sewer within three hundred (300) feet of the property line, the property owner shall be required to connect to the District's sanitary sewer system.
6. The Applicant and District agree that the provision of sanitary sewer service touches and concerns the property and the terms of this Agreement bind the District and Applicant and their heirs, executors, administrators, personal representatives, successors, agents, attorneys, assigns, designees, and transferees.

The parties hereto have read and fully understand the above provisions and agree to comply with said provisions.

FALL CREEK REGIONAL WASTE DISTRICT  
[Signature]  
Signature

APPLICANT  
[Signature]  
Signature

STATE OF INDIANA )  
                                  ) SS:  
COUNTY OF MADISON )

SUBSCRIBED and sworn to before me this 3 day of Sept, 2020



Signature [Signature]  
Printed Rachel E. Anderson  
Notary Public  
Resident of Madison County


\*\*\*\*\*

Inspector Kyle Date Inspected 5/7/21 Approved ✓ Rejected \_\_\_\_\_  
Reason for Rejection \_\_\_\_\_

Date Reinspected \_\_\_\_\_ Approved \_\_\_\_\_ Rejected \_\_\_\_\_

Notes:

Size Pipe 6" Type Pipe SDR 35  
Basement Yes No  
Sump Pump Yes No  
Downspout to Ground Yes No  
Septic Tank Pumped & Filled Yes No  
Contractor DR Watson  
Special Conditions \_\_\_\_\_  
Existing Home \_\_\_\_\_  
New Construction ✓

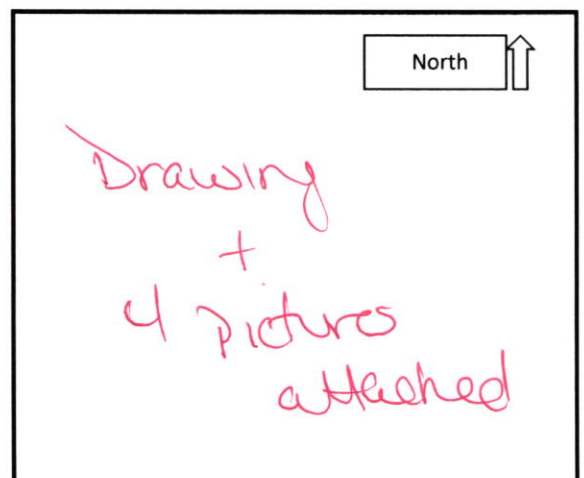




Fiddlers Green Lot #108

5/7/21


22

DR Watson

865 W Barouche

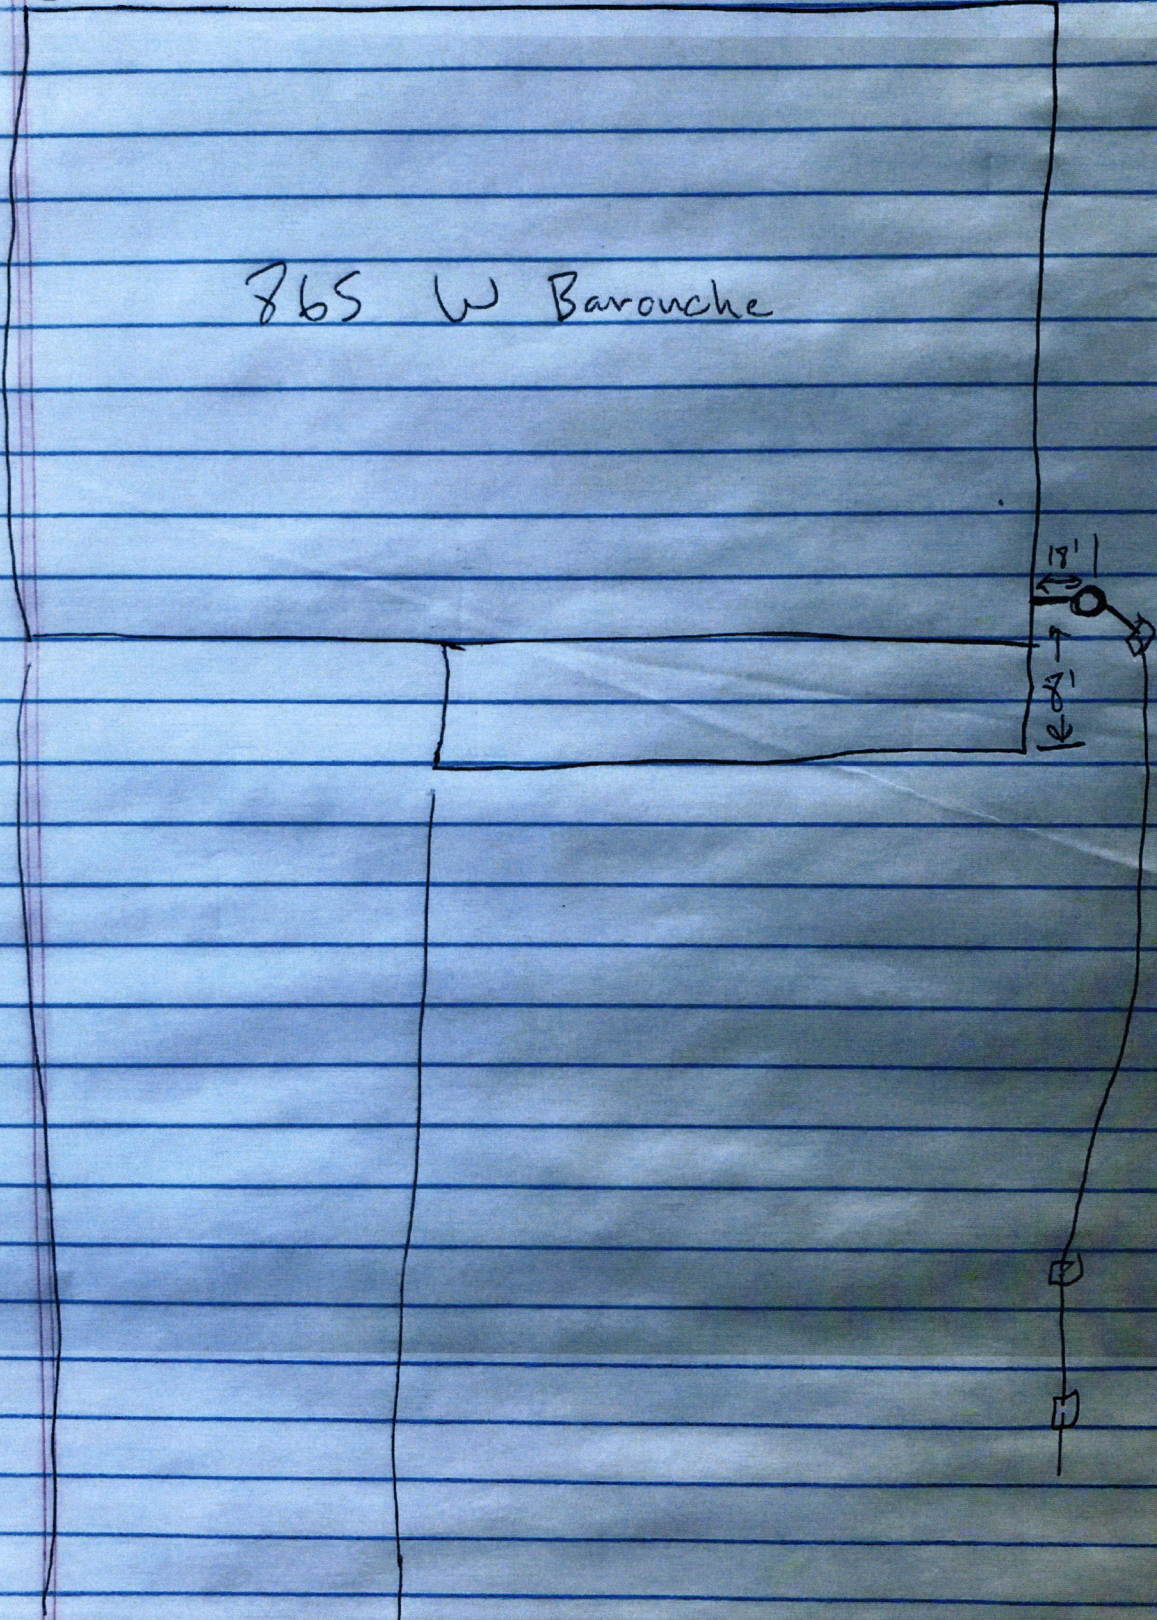



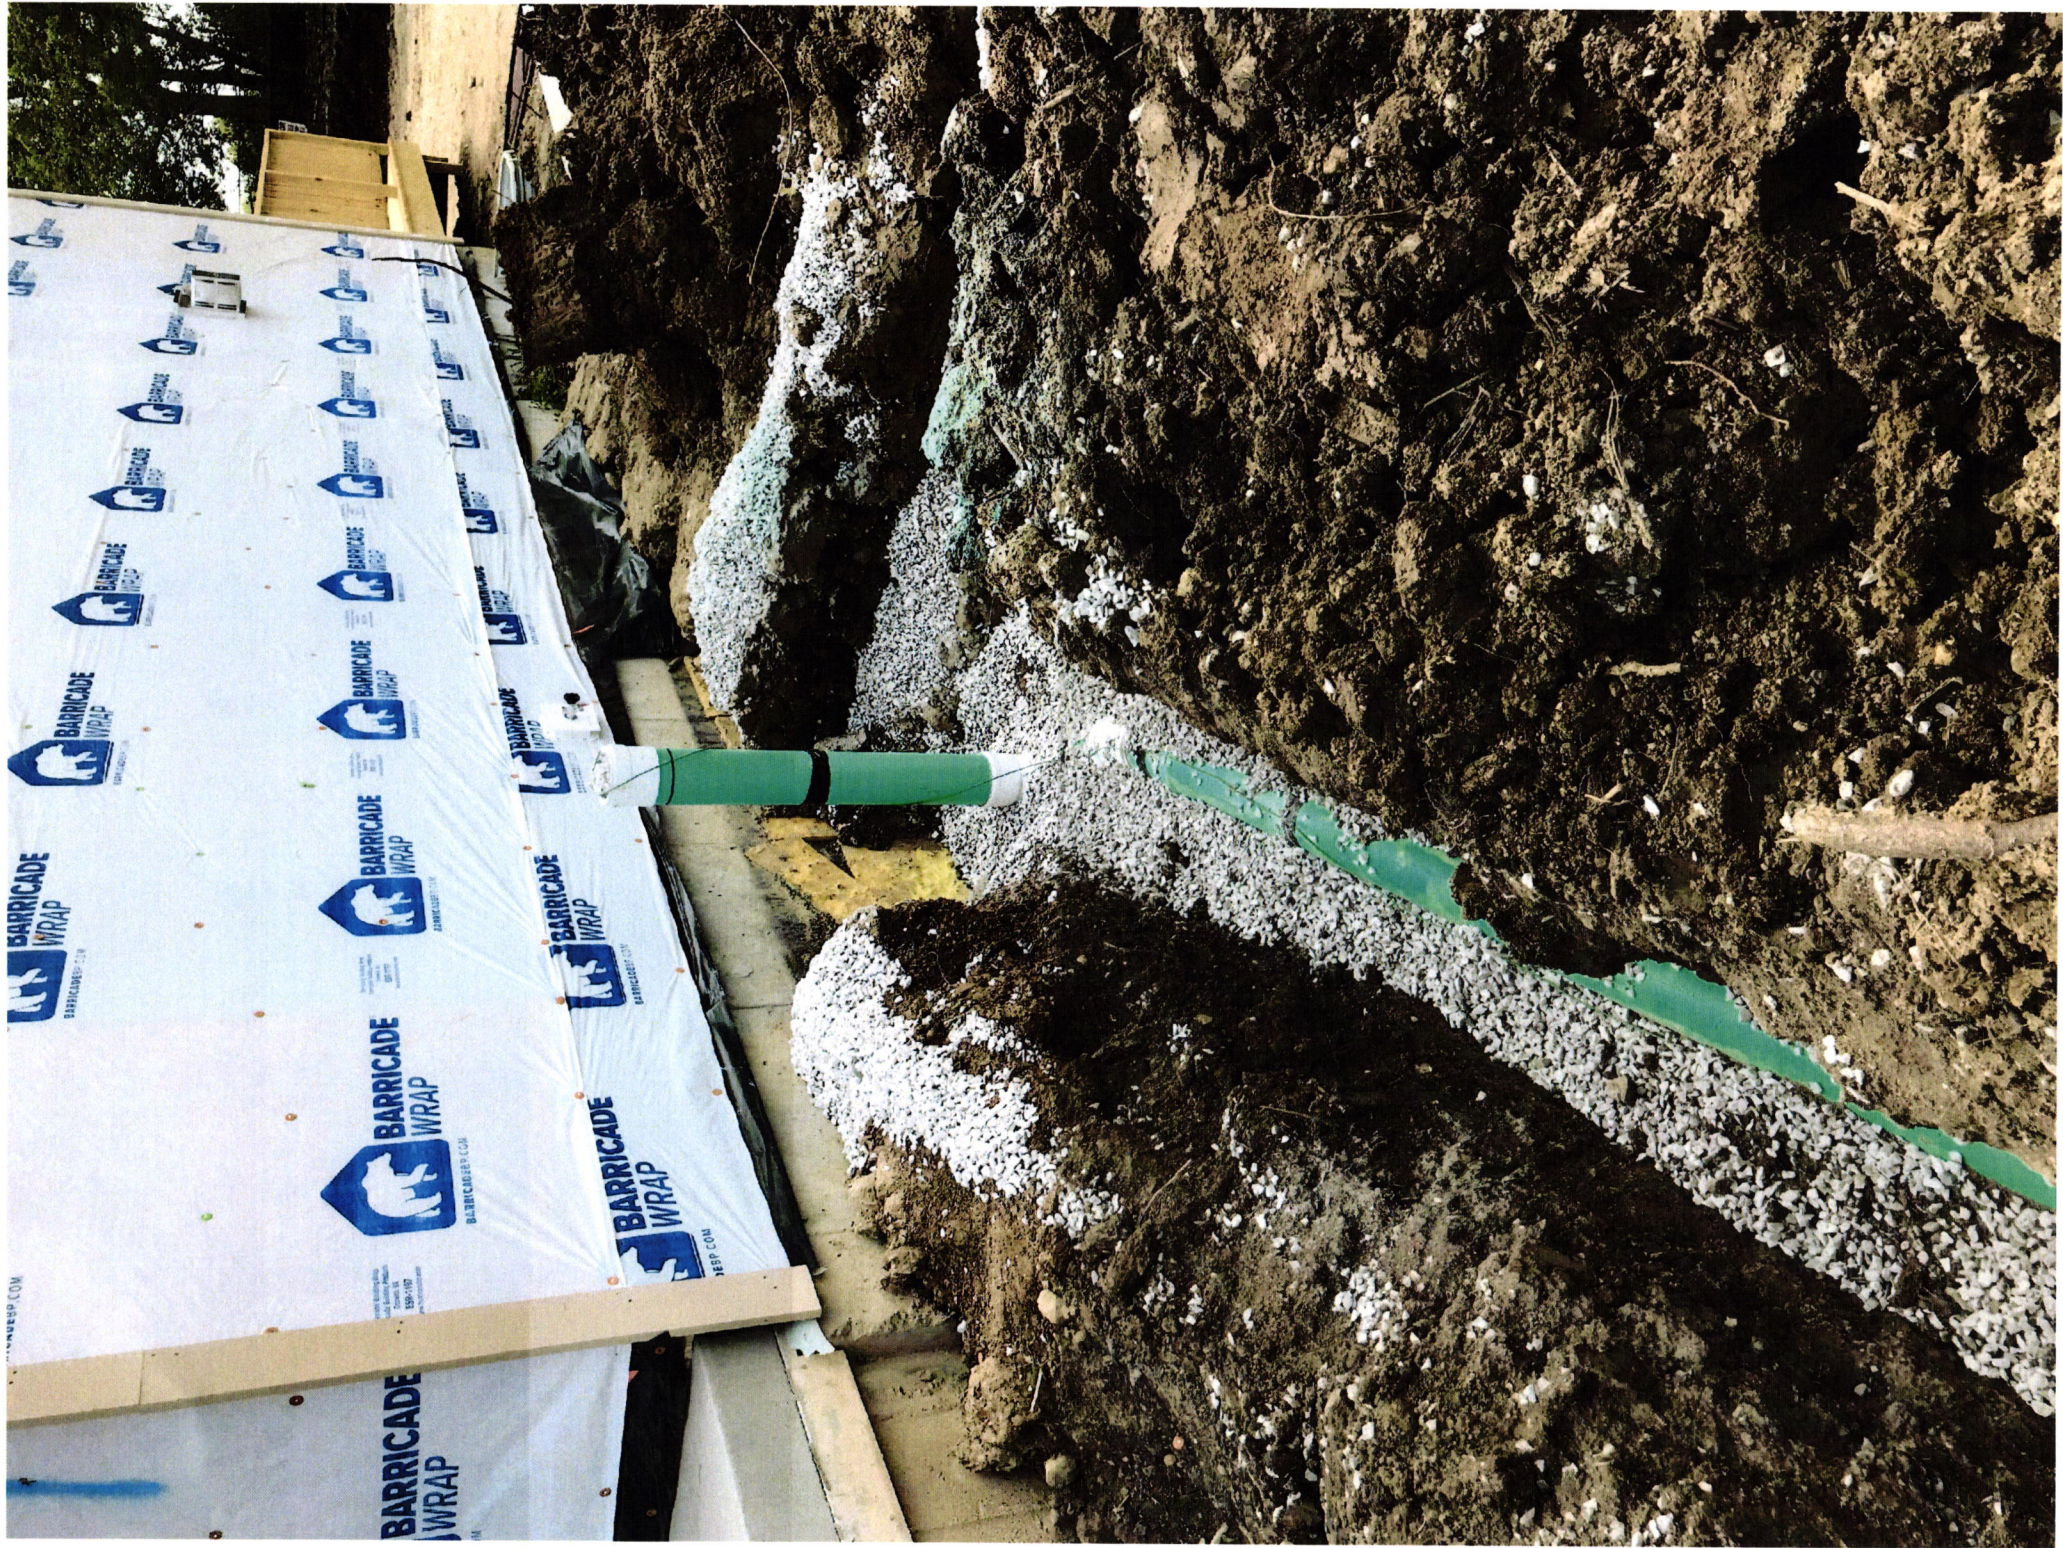















**Davis Building Group, LLC**3950 Priority Way S. Dr. Ste 210  
Indianapolis, IN 46240  
317-663-8340**Greenfield Banking Company**  
Greenfield, IN 46140  
71-367/749

13509

8/20/2020

PAY TO THE ORDER OF **Fall Creek Regional Waste District**

\$\*\*4,160.00

Four Thousand One Hundred Sixty and 00/100\*\*\*\*\*

DOLLARS

**Fall Creek Regional Waste District**  
9378 S. 650 W  
P.O. Box 59  
Pendleton, IN 46064-0059

PROTECTED AGAINST FRAUD

MEMO **WALTERS 451 SEWER PERMIT***Heather Payne***Davis Building Group, LLC****Fall Creek Regional Waste District**

Date 8/20/2020 Type Bill Reference WALTERS 451

Original Amt. 4,160.00

Balance Due 4,160.00

8/20/2020

Discount

Check Amount

Payment 4,160.00  
4,160.00

13509

*Rec # 011350*Greenfield Banking C **WALTERS 451 SEWER PERMIT**

4,160.00