

add order
on file



FALL CREEK REGIONAL WASTE DISTRICT

9378 S. 650 West PO Box 59
Pendleton, IN 46064-0059 778-7544

22-20817.00

Nº 2342

APPLICATION FOR SEWER PERMIT

Date 2/23/96

Permit Void 90 days from Date of Issuance

Owner Name Kent Machine, Inc. (Harold Kennedy)

Property Address S SR 9 8677 S. SR 9

Lot # _____ P.O. Box _____

Town Pendleton, IN Zip Code 46064

Phone 649-2778 644-7303 City Water _____ Well ☒

\$ 3200.00 Tap on Fee Paid

\$ _____ Inspection fee paid

Application is hereby made for connection to the Fall Creek Regional Waste District Sewer System for the above listed property - Permit Type: Residential ☒, Commercial _____, Industrial _____, or Governmental/Institutional _____. User Information _____.

All workmanship and materials shall conform to the standards of the District Ordinance as described in Ordinance 84-2 and 84-3 as amended. Acceptance and approval must be made by the District inspector or his duly authorized representative before backfilling and final connection is made to the main sewer lines. Any violation of applicable regulations will cause all lines and appurtenances in violation to be removed and replaced at the owners expense.

The Fall Creek Regional Waste District is responsible for the inspection, approval of materials, and installation techniques only. All costs for materials and installation and any liabilities resulting from same is the sole responsibility of the property owner.

I have read and fully understand the above provisions and agree to comply by said provisions.

APPLICANT(S) SIGNATURE

INSPECTOR Ben

Date inspected 10-10-96 Approved ☒ Rejected ☒

Reason for rejection Glue Joint Pipe / wrong tank / wrong outlet pipe
wrong Back Fill MATERIAL

Date reinspected 11-1-96 Approved _____ Rejected _____

Notes:

Size Pipe 6 "

Type Pipe PVC

Basement Yes _____ No ☒

Sump Pump Yes _____ No ☒

Downspout to Ground Yes ☒ No _____


Septic Tank Pumped & filled Yes _____ No ☒

Contractor M + M

Special Conditions _____

Existing Home _____

New Construction ☒

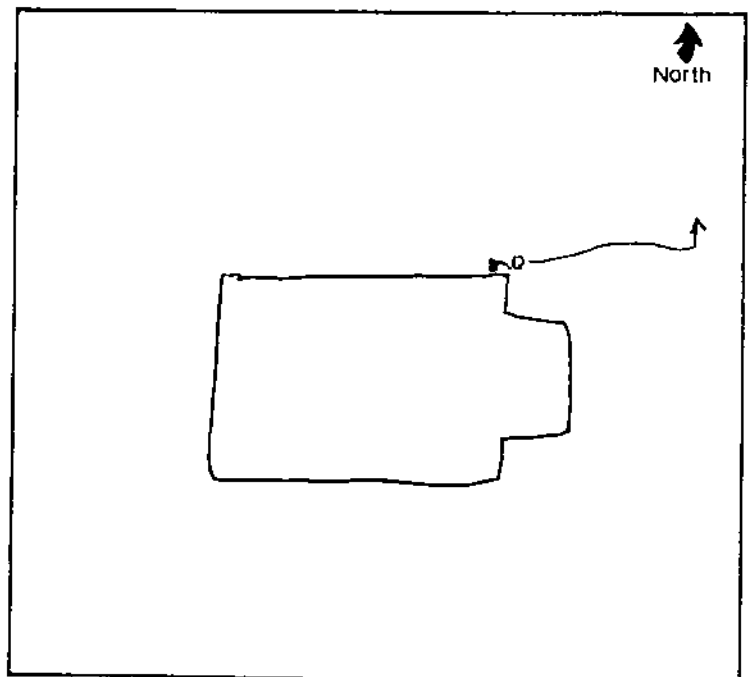



KENT MACHINE, INC.

2418 BROWN ST. 644-7303
ANDERSON, INDIANA 46016

NATIONAL CITY BANK, INDIANA
ANDERSON, INDIANA

20-6
740

012612

PAY --Three Thousand Two Hundred Dollars and 00/100-----
DATE

TO THE
ORDER
OF

FALL CREEK REGIONAL WASTE

02/22/96

\$3,200.00

Jane Kennedy
AUTHORIZED SIGNATURE

NP

⑈012612⑈ ⑆074000065⑆

KENT MACHINE, INC.

012612

TO: FALL CREEK REGIONAL WASTE
For: SEWAGE HOOK-UP

3,200.00 02/22/96

904

KENT MACHINE
HAROLD
SR 9 Kennedy
South of 67 House
649-2778
office
644-7303
2418 \$3200
TRAP FEE