


8687
8688 Strabet DR

Springbrook Lot 213

Don Moore 10/28/2021

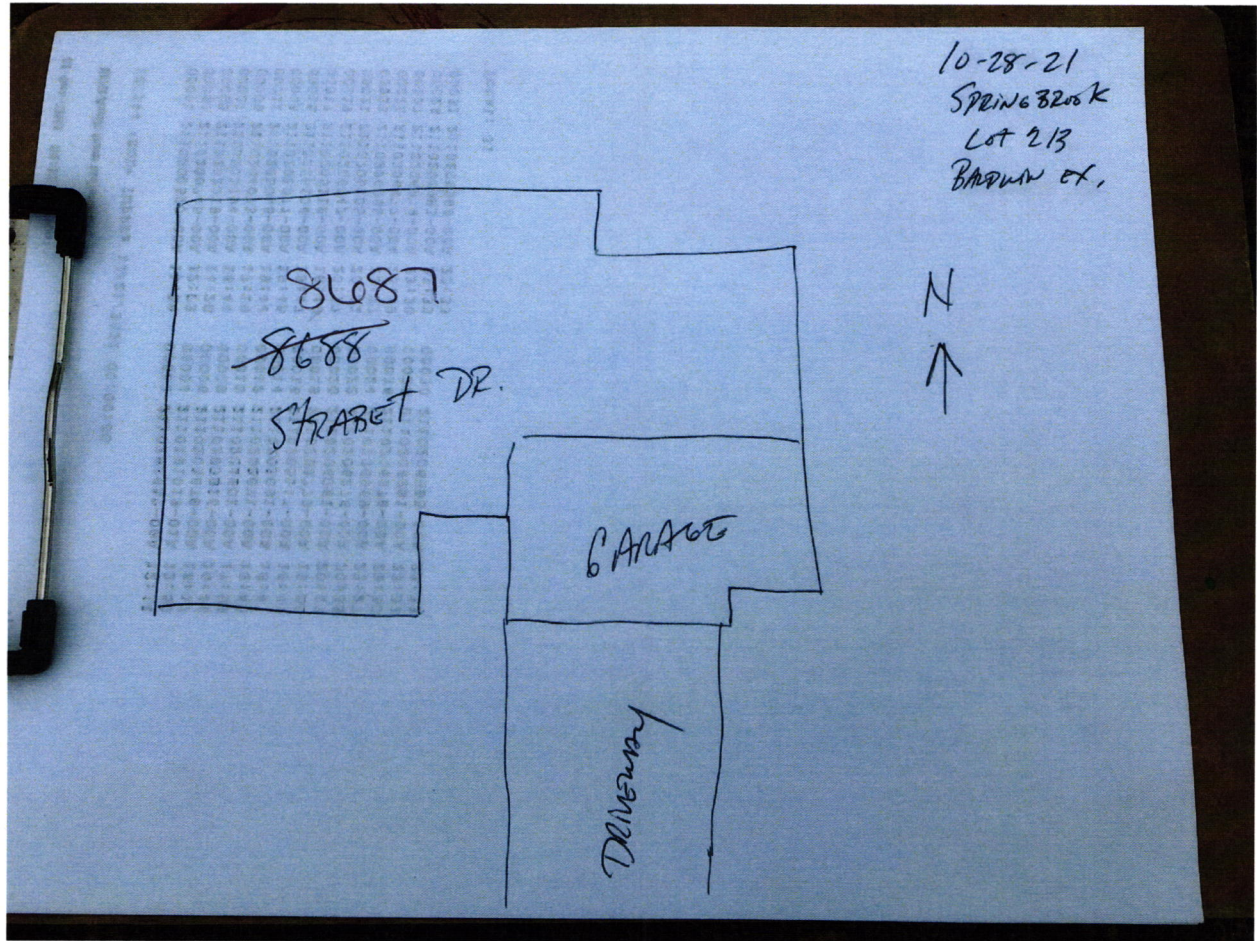

8687

8688 Strabet DR

Springbrook Lot 213

Don Moore 10/28/2021




Lennar Homes of Indiana, Inc.Indianapolis Division
11555 N Meridian St Ste 400
Carmel, IN 46032JPMorgan Chase Bank N.A.
Chicago, IL**01635431**70-2322
719

Void if over 180 days

DATE	AMOUNT
06/14/21	\$*****760.00

PAY

SEVEN HUNDRED SIXTY AND 00/100 *****

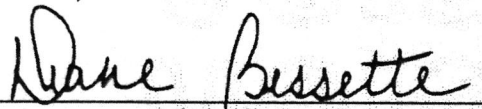DOLLARSTO
THE
ORDER
OFFall Creek Regional Waste District
PO Box 59
Pendleton IN 46064
Authorized Signatory

Rec # 011748