


North 


Drawing  
+  
1 picture  
attached







Springbrook  
LOT 94  
8705 Moyer Pl.  
5/20/21

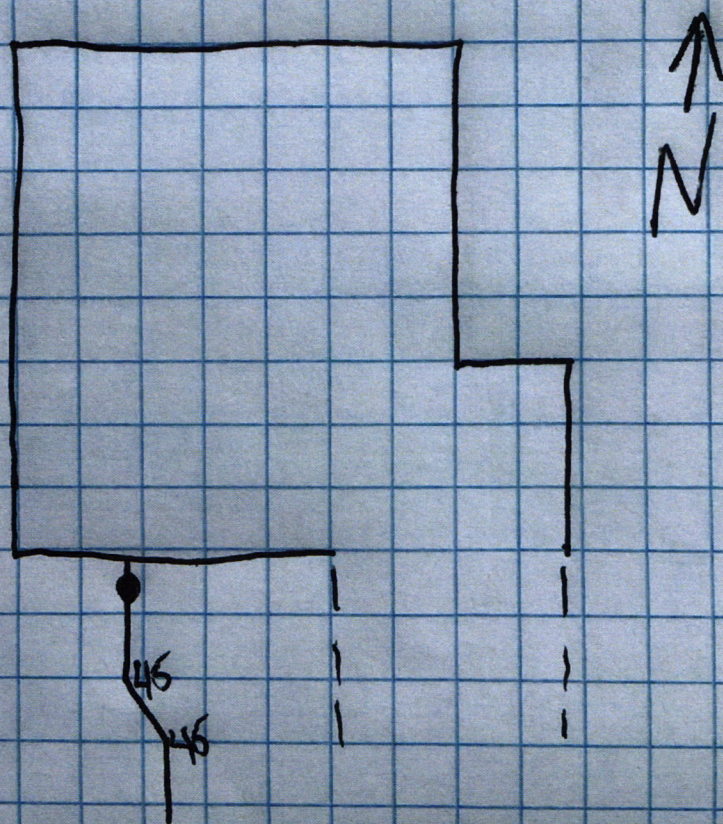







**Lennar Homes of Indiana Inc**  
11555 N Meridian St Ste 400

JPMorgan Chase Bank N.A.  
Chicago, IL

**01581356**

Carmel, IN 46032

Void if over 180 days

70-2322  
719

**PAY**


DATE	AMOUNT
03/08/21	\$*****760.00

SEVEN HUNDRED SIXTY AND 00/100 \*\*\*\*\*

DOLLARS

TO  
THE  
ORDER  
OF

Fall Creek Regional Waste District  
PO Box 59  
Pendleton IN 46064

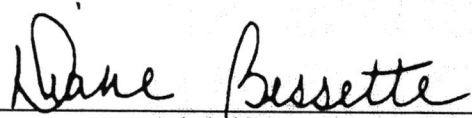  
Authorized Signatory

Rec # 011602