



FALL CREEK REGIONAL WASTE DISTRICT

9378 S. 650 West PO Box 59  
Pendleton, IN 46064-0059 778-7544

add order  
on file

Nº 2077

APPLICATION FOR SEWER PERMIT

Date

4/21/94

Permit Void 90 days from Date of Issuance

Owner Name

Mustin Builders - Mark Martin

Property Address

8710 Carriage

Lot #

88 - Giddlers Green

P.O. Box

Town

IN Zip Code

Phone

City Water

Well

✓

\$

700.00

Tap on Fee Paid

\$

25.00

Inspection fee paid

Application is hereby made for connection to the Fall Creek Regional Waste District Sewer System for the above listed property - Permit Type: Residential ☒, Commercial ☐, Industrial ☐, or Governmental/Institutional ☐. User Information

All workmanship and materials shall conform to the standards of the District Ordinance as described in Ordinance 84-2 and 84-3 as amended. Acceptance and approval must be made by the District inspector or his duly authorized representative before backfilling and final connection is made to the main sewer lines. Any violation of applicable regulations will cause all lines and appurtenances in violation to be removed and replaced at the owners expense.

The Fall Creek Regional Waste District is responsible for the inspection, approval of materials, and installation techniques only. All costs for materials and installation and any liabilities resulting from same is the sole responsibility of the property owner.

I have read and fully understand the above provisions and agree to comply by said provisions.

APPLICANT(S) SIGNATURE

INSPECTOR

TM

Date inspected

8-24-94

Approved

Rejected

Reason for rejection

Date reinspected

Approved

Rejected

Notes:

Size Pipe

6"

Type Pipe

SDR 35

Basement Yes

No

Sump Pump Yes

No

Downspout to Ground Yes

No

Septic Tank Pumped & filled Yes

No


Contractor

Bolton Const.

Special Conditions

Existing Home

New Construction

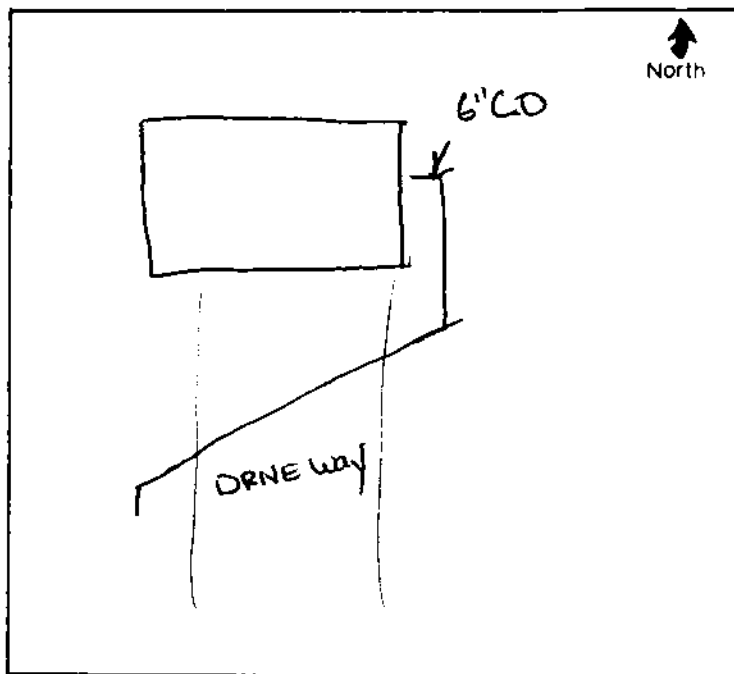



**MUSTIN BUILDERS, INC.**

810 CENTRAL AVENUE  
ANDERSON, IN 46012  
PH. 317-644-8502

CITIZENS BANKING CO.  
ANDERSON, IN 46015  
71-70-748

13401

PAY: One Thousand Four Hundred Fifty and no/100 Dollars

DATE  
4-20-94

CHECK NO.  
13401

AMOUNT  
\$1,450.00

PAY  
TO THE  
ORDER  
OF

Fall Creek Regional Waste District  
P. O. Box 59  
Pendleton, IN 46064

p fee for Lot 88 Fiddler's Green - \$725.00  
p fee for Lot 101 Fiddler's Green - \$725.00

⑈013401⑈ ⑆074900709⑆

# RECEIPT

FALL CREEK REGIONAL WASTE DISTRICT

P.O. BOX 59, CO. RD. 650 WEST

NO 4392

*gla* \_\_\_\_\_ FUND

PENDLETON, IND. 46064, 4/31 1994

RECEIVED FROM Muati Builders, Inc. \$ 1450.00

THE SUM OF fourteen hundred fifty & 00/100 100 DOLLARS

ON ACCOUNT OF tap & inspection fees

lot 884 lot 101 - Fiddler's Green

Walter Wilson

PAID BY: CASH ☐ CHECK ☐ M.O. ☐

AUTHORIZED SIGNATURE