

# FALL CREEK REGIONAL WASTE DISTRICT

9378 S 650 WEST, P.O. BOX 59, PENDLETON, IN 46064

765-778-7544

## AGREEMENT FOR SANITARY SEWER SERVICE

This Agreement made and entered into this 5<sup>th</sup> day of Feb, 2001, between FALL CREEK REGIONAL WASTE DISTRICT ("District") and Clarence Muehle ("Applicant") regarding the provision of sanitary sewer service, and the assignment of capacity in, and connection to, the District's facilities for the premises located at 8729 N. Old Fort Road Scott King

**NOW THEREFORE**, the parties, in consideration of the mutual promises set out in this Agreement, the receipt and sufficiency of which is hereby acknowledged, agree as follows:

1. The Applicant agrees that all workmanship and materials shall conform to all District ordinances and the District's construction standards. District must accept and approve all work and materials before backfilling and final connection is made to the sewer mains. Any violation of this provision will cause all lines and appurtenances in violation to be removed and replaced at the Applicant's expense.
2. The District shall have the right to enter upon the Applicant's premises at all reasonable times to inspect, repair, or replace any equipment used in connection with the District's service or which has an impact on said service.
3. The Applicant shall be responsible for all monthly user rates, capacity charges, and tap fees. The failure to pay any rate charge or fee may result in a lien against the property and/or the termination of service to the property, the cost of which will be borne by Applicant, including, but not limited to, all attorney's fees and collection costs.
4. The District shall not be responsible for any damages as a result of any failure to supply service unless said damages are due to default, neglect or culpability on the part of the District.
5. If there is an available sanitary sewer within three hundred (300) feet of the property line, the property owner shall be required to connect to the District's sanitary sewer system.
6. The Applicant and District agree that the provision of sanitary sewer service touches and concerns the property and the terms of this Agreement bind the District and Applicant and their heirs, executors, administrators, personal representatives, successors, agents, attorneys, assigns, designees, and transferees.

The parties hereto have read and fully understand the above provisions and agree to comply with said provisions.

FALL CREEK REGIONAL WASTE DISTRICT

Signature Sam Carey

APPLICANT

Signature \_\_\_\_\_

STATE OF INDIANA )  
 ) SS:  
COUNTY OF MADISON )

SUBSCRIBED and sworn to before me this \_\_\_\_\_ day of \_\_\_\_\_, 2001.

My Commission Expires: \_\_\_\_\_

Signature \_\_\_\_\_

Printed \_\_\_\_\_

Notary Public  
Resident of Madison County

\*\*\*\*\*  
INSPECTOR Ben DATE INSPECTED 2-5-11 APPROVED / REJECTED \_\_\_\_\_

REASON FOR REJECTION \_\_\_\_\_

DATE REINSPECTED \_\_\_\_\_ APPROVED \_\_\_\_\_ REJECTED \_\_\_\_\_

NOTES:  
SIZE PIPE 6" TYPE PIPE PVC

BASEMENT YES NO Y

SUMP PUMP YES NO Y

DOWNSPOUT TO GROUND YES NO Fisher


SEPTIC TANK PUMPED & FILLED YES NO Y

CONTRACTOR Swaggy

SPECIAL CONDITIONS \_\_\_\_\_

EXISTING HOME X

NEW CONSTRUCTION \_\_\_\_\_

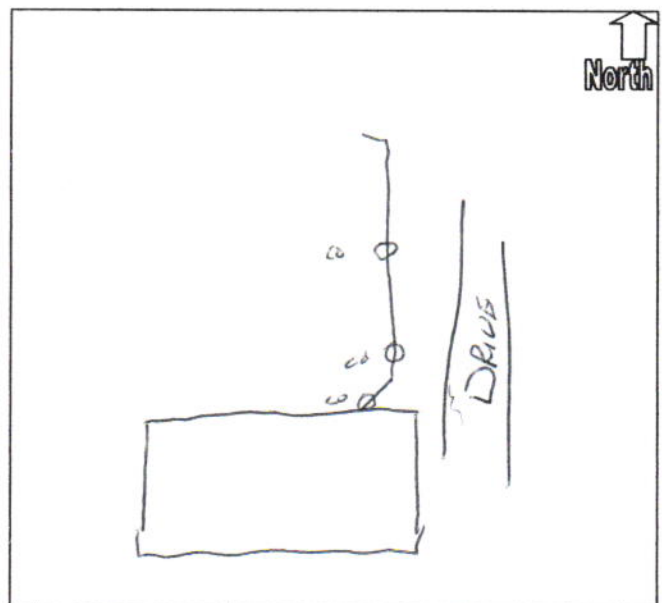

STATIC INFORMATION  
CHANGE

Account No 260702000  
Name MUTCHLER, CLARENCE Search Name MUTCHLER, CLARE  
Address 1 1227 DIVISION ST Serv Address 8729 W OLD FORT ROAD  
Address 2 Carrier Route  
City St Zip NOBLESVILLE IN 46060 0000 Search Address  
Soc Sec No. 312246640 Phone 317 4856665 No. 8729 Name W OLD FORT ROAD

Owners Information

B A N K

Name  
Address  
City St Zip 00000 0000  
Soc Sec No. 000000000 Phone 000 0000000

Number Amount  
Account

In/Out Pen Exempt Y  
Final F Apartments

Dates  
Last Bill 52699  
Due..... 61599  
Last Paid 60299  
Start....

Legal  
Description

CMD1-Nxt Act CMD2-Prv Act CMD4-Refresh CMD5-Dup Ownr CMD6-Billing CMD7-END

*Mrs. Scott King called on 12/6/01 and they are now the owners of the above property. Her and her husband bought this in May or June. They have not gotten a certified letter. Their phone number is 317-485-5278*