#7636

Fall Creek Regional Waste District 9378 S 650 W, P.O. Box 59, Pendleton, IN 46064 765-778-7544

Agreement for Sanitary Sewer Service

This Agreement made and entered into this 13 day of, 20 1, between Fall Creek Regional Waste District ("District") and tennar Homes ("Applicant") regarding the provision of sanitary sewer service, and the assignment of capacity in and connection to, the District's facilities for the premises located at Springbrook Lot 217	
Street Address: 8734 Strabet Or.	
Now therefore, the parties, in consideration of the mutual promises set out in this Agreement, the receipt and sufficiency of which is hereby acknowledged, agree as follows:	
 The Applicant agrees that all workmanship and materials shall conform to all District ordinances and the District's construction standards. District must accept and approve all work and materials before backfilling and final connection is made to the sewer mains. Any violation of this provision will cause all lines and appurtenances in violation to be removed and replaced at the Applicant's expense. The District shall have the right to enter upon the Applicant's premises at all reasonable times to inspect, repair, or replace any equipment used in connection with the District's service or which has an impact on said service. The Applicant shall be responsible for all monthly user rates, capacity charges, and tap fees. The failure to pay any rate charge or fee may result in a lien against the property and/or the termination of service to the property, the cost of which will be borne by Applicant, including, but not limited to, all attorney's fees and collection costs. The District shall not be responsible for any damages as a result of any failure to supply service unless said damages are due to default, neglect or culpability on the part of the District. If there is an available sanitary sewer within three hundred (300) feet of the property line, the property owner shall be required to connect to the District's sanitary sewer system. The Applicant and District agree that the provision of sanitary sewer service touches and concerns the property and the terms of this Agreement bind the District and Applicant and their heirs, executors, administrators, personal representatives, successors, agents, attorneys, assigns, designees, and transferees. 	
The parties hereto have read and fully understand the above provisions and agree to comply with said provisions.	
failed xany	APPLICANT Signature
STATE OF INDIANA)) SS:	
COUNTY OF MADISON)	
SUBSCRIBED and sworn to before me this 3 day of 4, 20 31 My Commission Expires OFFICIAL SEAL RACHEL ELAINE ANDERSON NOTARY PUBLIC-STATE OF INDIANA MADISON COUNTY MY COMM. EXPIRES OCTOBER 23, 2021 Notary Public Resident of Maddan County	
Inspector Date Inspected Approved Rejected	
Notes: / / Approved Approved	Rejected
Size Pipe 6 Type Pipe 100 35 Basement Yes No	
Sump Pump <u>Yes No</u>	North
Downspout to Ground <u>Yes No</u> Septic Tank Pumped & Filled <u>Yes No</u>	
Contractor KATOWN BC.	Drawing
Special Conditions Existing Home	+
New Construction	2 sintures
	a tached

PACIFIC BANGE AND LESCON

NOTART FEB. C. SINTE OF INDIANA

NACHONI E. 1883 OCTOBER 77, 2001

STOEPPELWERTH

7965 East 106th Street, Fishers, IN 46038-2505 phone: 317.849.5935 fax: 317.849.5942

JOB ID SPRINGBK5.217

CONTROL# 99067 LEN

PARCEL#N/A

8734 STRABET DRIVE PENDLETON, IN 46064



1" = 30'

LOT AREA: 9,100 Sq. Ft.

M.F.F.E.=864.4 M.F.P.G.=864.4

LEGEND: XX.X

PROPOSED GRADE PER PLAN XX.XAB

AS BUILT GRADE

S.S.D. SUB-SURFACE DRAIN SANITARY SEWER
6" AS BUILT SANITARY LATERAL
6" PROPOSED SANITARY LATERAL ASL STORM SEWER W 3/4" WATER CONNECTION WATER MAIN SWALE

SANITARY MANHOLE

STORM MANHOLE



CURB INLET FIRE HYDRANT



WATER VALVE



STREET TREE

D.&U.E.

DRAINAGE & UTILITY EASEMENT

BUILDING LINE MINIMUM FINISHED FLOOR


M.F.F.E.

FLEVATION MINIMUM FLOOD PROTECTION

M.F.P.G.

GRADE

CONTRACTOR SHALL CUT 15' OFF OF LATERAL AND BEGIN FROM THAT POINT AND CONNECT TO HOUSE FOLLOWING PLOT PLAN.

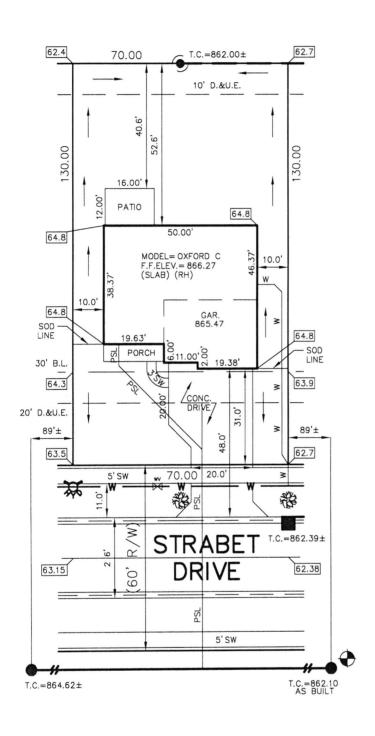

ALL UNDERGROUND SEWERS AND UTILITIES SHOWN ARE PLOTTED BY SCALE FROM DESIGN PLANS FURNISHED BY ENGINEER THE ACTUAL FIELD LOCATION MAY VARY.

LOT 217 **SPRINGBROOK** SECTION 5

INST. #(UNRECORDED) ZONING: R3 5' MINIMUM SIDE YARD 30' MINIMUM FRONT YARD

15' MINIMUM REAR YARD THIS PLOT PLAN WAS PREPARED FROM AN UNRECORDED PLAT AND IS SUBJECT TO CHANGE.



SOD: SEEDING: SEED IN EASEMENT: CONC. DRIVEWAY:
PRIVATE WALK:
PUBLIC WALK: APRON: ADDITIONAL SOD TO: REAR EASEMENT HANDICAP RAMPS:

229 ± Sq. 4,339 ± Sq. Ft. 700 ± Sq. Ft. 819 ± Sq. Ft. Sq. Ft. 31± 250 ± Sq. Ft. 435 ± Sq. Ft. Sq. 404 ±




NOTE: THIS DRAWING IS NOT INTENDED TO BE REPRESENTED AS A RETRACEMENT OR ORIGINAL BOUNDARY SURVEY, A ROUTE SURVEY OR A SURVEYOR LOCATION REPORT.




DATE: SIGNATURE: SIGNATURE REPRESENTS CONFIRMATION OF RECEIPT OF PLOT PLAN BY CUSTOMER

0

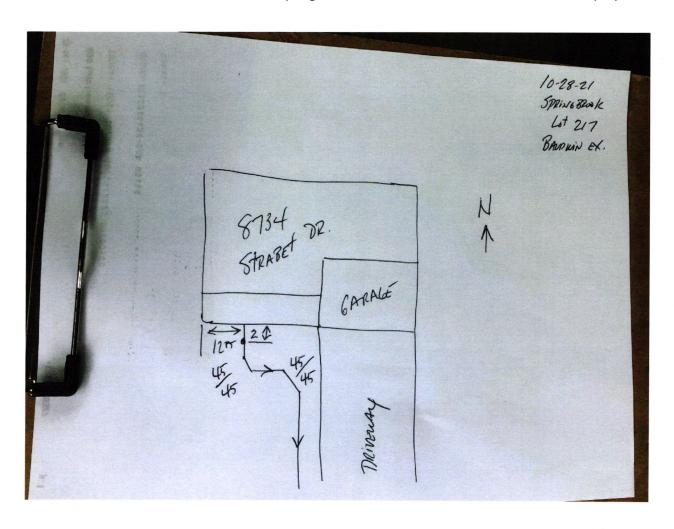



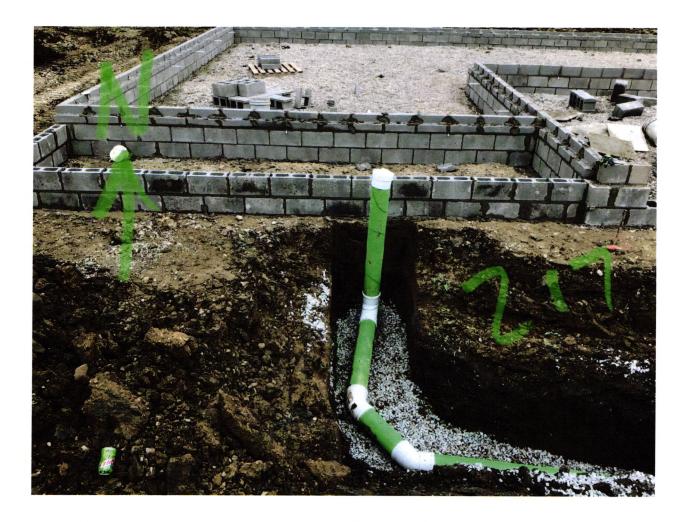

Lennar Corporation Lennar Homes of Indiana, Inc. Indianapolis Division 11555 N Meridian St Ste 400 Carmel, IN 46032

CHECK NUMBER

1648466

70-2322 719

July 12, 2021

*** VOID AFTER 180 DAYS ***

PAY

Chicago, IL

FALL CREEK REGIONAL WASTE DISTRICT

TO THE

PO BOX 59

JPMorgan Chase Bank, N.A.

ORDER OF: PENDLETON, IN 46064

CHECK AMOUNT

\$760.00

EXACTLY *******760 DOLLARS AND 00 CENTS

Authorized Signature

lec# 011808