

add order
on file



FALL CREEK REGIONAL WASTE DISTRICT

9378 S. 650 West PO Box 59
Pendleton, IN 46064-0059 778-7544

22-02623.00

Robert S. Taylor

No 2110

APPLICATION FOR SEWER PERMIT

Date

7/11/94

Permit Void 90 days from Date of Issuance

Owner Name

Barry Staldine

Property Address

8743 Surrey

Lot #

86 - section 5

P.O. Box

Town

Pendleton

IN

Zip Code

46064

Phone

City Water

Well

✓

\$ 350.00

Tap on Fee Paid

\$ 25.00

Inspection fee paid

Application is hereby made for connection to the Fall Creek Regional Waste District Sewer System for the above listed property - Permit Type: Residential ☒, Commercial ☐, Industrial ☐, or Governmental/Institutional ☐. User Information

All workmanship and materials shall conform to the standards of the District Ordinance as described in Ordinance 84-2 and 84-3 as amended. Acceptance and approval must be made by the District inspector or his duly authorized representative before backfilling and final connection is made to the main sewer lines. Any violation of applicable regulations will cause all lines and appurtenances in violation to be removed and replaced at the owners expense.

The Fall Creek Regional Waste District is responsible for the inspection, approval of materials, and installation techniques only. All costs for materials and installation and any liabilities resulting from same is the sole responsibility of the property owner.

I have read and fully understand the above provisions and agree to comply by said provisions.

APPLICANT(S) SIGNATURE

INSPECTOR LM

Date inspected 8-26-94

Approved ☒

Rejected ☐

Reason for rejection

Date reinspected

Approved

Rejected

Notes:

Size Pipe 6"

Type Pipe SDR 35

Basement Yes ☐ No ☒

Sump Pump Yes ☐ No ☒

Downspout to Ground Yes ☒ No ☐


Septic Tank Pumped & filled Yes ☐ No ☐

Contractor Don Brown

Special Conditions

Existing Home ☐

New Construction ☒

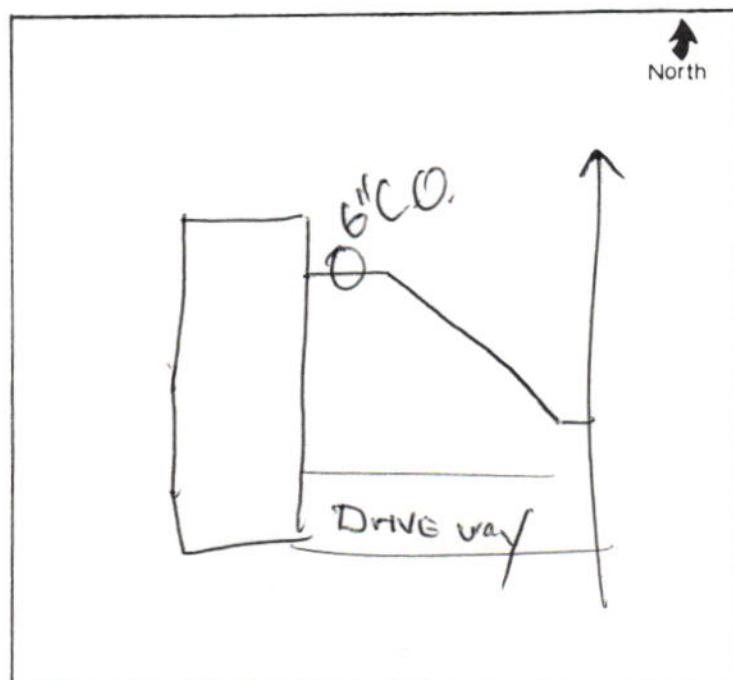

RECEIPT

FALL CREEK REGIONAL WASTE DISTRICT

P.O. BOX 59, CO. RD. 650 WEST

No 4504

gen FUND

PENDLETON, IND. 46064, 7/11 1994

RECEIVED FROM Robert D. Taylor \$ 375.00

THE SUM OF Three hundred seventy-five & 00/100 DOLLARS

ON ACCOUNT OF cap & inspection fee
Siddler's Green lot 86-Section 5, 8743 Survey

PAID BY: CASH ☐ CHECK ☒ M.O. ☐ 20269

Debbie Wilson

AUTHORIZED SIGNATURE