



FALL CREEK REGIONAL WASTE DISTRICT

9378 S. 650 West PO Box 59
Pendleton, IN 46064-0059 778-7544

add order
on file

22-02568.00

APPLICATION FOR SEWER PERMIT

Nº 2078

Date 4/21/94

Permit Void 90 days from Date of Issuance

Owner Name Mustin Builders

Property Address 8749 Carriage Lane

Lot # 101- Fiddlers Green P.O. Box _____

Town Pendleton, IN Zip Code 46064

Phone _____ City Water _____ Well ☒

\$ 700.00 Tap on Fee Paid

\$ 25.00 Inspection fee paid

Application is hereby made for connection to the Fall Creek Regional Waste District Sewer System for the above listed property - Permit Type: Residential ☒, Commercial _____, Industrial _____, or Governmental/Institutional _____. User Information _____.

All workmanship and materials shall conform to the standards of the District Ordinance as described in Ordinance 84-2 and 84-3 as amended. Acceptance and approval must be made by the District inspector or his duly authorized representative before backfilling and final connection is made to the main sewer lines. Any violation of applicable regulations will cause all lines and appurtenances in violation to be removed and replaced at the owners expense.

The Fall Creek Regional Waste District is responsible for the inspection, approval of materials, and installation techniques only. All costs for materials and installation and any liabilities resulting from same is the sole responsibility of the property owner.

I have read and fully understand the above provisions and agree to comply by said provisions.

APPLICANT(S) SIGNATURE _____

INSPECTOR DW

Date inspected _____ Approved ☒ Rejected _____

Reason for rejection _____

Date reinspected _____ Approved _____ Rejected _____

Notes:

Size Pipe 6"

Type Pipe PVC

Basement Yes _____ No _____

Sump Pump Yes _____ No _____

Downspout to Ground Yes ☒ No _____


Septic Tank Pumped & filled Yes _____ No ☒

Contractor Bilton Const.

Special Conditions _____

Existing Home _____

New Construction ☒

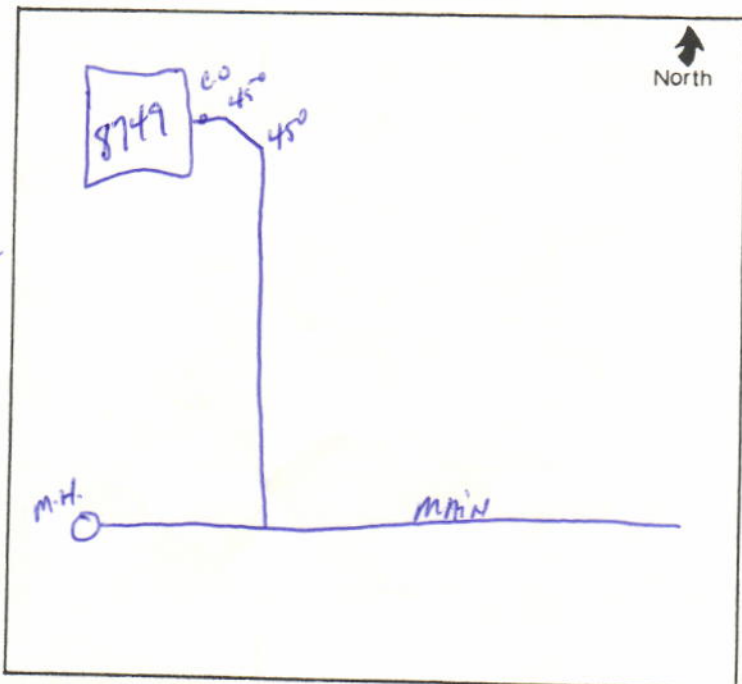



MUSTIN BUILDERS, INC.
810 CENTRAL AVENUE
ANDERSON, IN 46012
PH. 317-644-8502

CITIZENS BANKING CO.
ANDERSON, IN 46015
71-70-749

13401

PAY: One Thousand Four Hundred Fifty and no/100 Dollars

DATE
4-20-94

CHECK NO.
13401

AMOUNT
\$1,450.00

Y
THE
MER
F

Fall Creek Regional Waste District
P. O. Box 59
Pendleton, IN 46064

fee for Lot 88 Fiddler's Green - \$725.00
fee for Lot 101 Fiddler's Green - \$725.00

[Signature]

⑈013401⑈ ⑈074900709⑈

PRESCRIBED BY STATE BOARD OF ACCOUNTS ROYCE FORMS SYSTEMS, MUNCIE, IN.

GENERAL FORM NO. 357

RECEIPT

FALL CREEK REGIONAL WASTE DISTRICT
P.O. BOX 59, CO. RD. 650 WEST

№ 4392

gen FUND

PENDLETON, IND. 46064, 4/21 1994

RECEIVED FROM Mustin Builders, Inc. \$ 1450.00

THE SUM OF Fourteen hundred fifty & 00/100 DOLLARS

ON ACCOUNT OF tap & inspection fees
lot 88 & lot 101 - Fiddler's Green

Abbie Wilson

PAID BY: CASH ☐ CHECK ☐ M.O. ☐

AUTHORIZED SIGNATURE