



FALL CREEK REGIONAL WASTE DISTRICT

Box 44, Pendleton, Indiana 46064

22-02591.00

Robert Taylor

Nº 001865

APPLICATION FOR SEWER PERMIT

Permit No. _____ Date 9/4/92
Permit Void 90 days from Date of Issuance 3-6-93
Owner Name Janice Schulte 4-7-93
Property Address 8761 Carriage Lane
Lot # 78 P.O. Box _____
Town Pendleton, IN Zip Code 46064
Phone _____ Water Meter Robert Taylor
\$ 350.00 Tap on Fee Paid (700.00) kept the refund.
\$ 25.00 Inspection fee paid portion and just sent in 350.00.

Application is hereby made for connection to the Fall Creek Regional Waste District Sewer System for the above listed property - Permit Type: Residential X, Commercial _____, Industrial _____, or Governmental/Institutional _____. User Information _____.

All workmanship and materials shall conform to the standards of the District Ordinance as described in Ordinance 84-2 and 84-3 as amended. Acceptance and approval must be made by the District inspector or his duly authorized representative before backfilling and final connection is made to the main sewer lines. Any violation of applicable regulations will cause all lines and appurtenances in violation to be removed and replaced at the owners expense.

The Fall Creek Regional Waste District is responsible for the inspection, approval of materials, and installation techniques only. All costs for materials and installation and any liabilities resulting from same is the sole responsibility of the property owner.

I have read and fully understand the above provisions and agree to comply by said provisions.

APPLICANT(S) SIGNATURE

INSPECTOR


TIM

Date inspected 9-4-92 Approved / Rejected _____

Reason for rejection _____

Date reinspected _____ Approved _____ Rejected _____

Notes:
Size Pipe 6"
Type Pipe PVC SDR 35
Basement Yes / No /
Sump Pump Yes / No /
Downspout to Ground Yes / No /
Septic Tank Pumped & filled Yes / No /
Contractor Brown Brothers
Special Conditions 36" Bucket

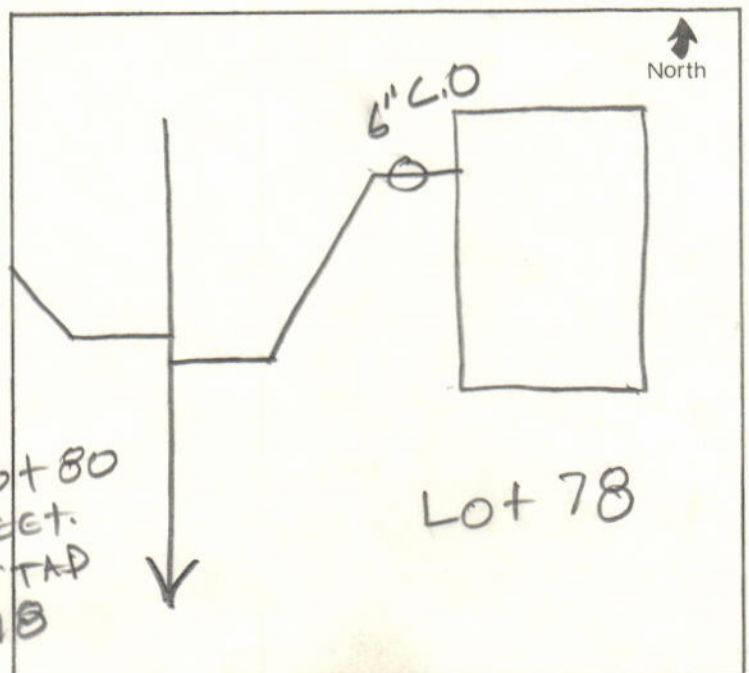

TAP For Lot 80
IS TWO FEET
NORTH OF TAP
FOR LOT 78