



FALL CREEK REGIONAL WASTE DISTRICT

Box 44, Pendleton, Indiana 46064

2-0002599.00

APPLICATION FOR SEWER PERMIT

Nº 001741

Permit No. _____ Date 5-17-90
Permit Void 90 days from Date of Issuance
Owner Name Robert TAYLOR INC
Property Address 8766 CARRIAGE LN
Lot # 74 P.O. Box _____
Town PENDLETON, IN Zip Code 46064
Phone _____ Water Meter _____
\$ 175.00 Tap on Fee Paid
\$ 25.00 Inspection fee paid 5-21-90

Application is hereby made for connection to the Fall Creek Regional Waste District Sewer System for the above listed property - Permit Type: Residential ☒, Commercial _____, Industrial _____, or Governmental/Institutional _____. User Information _____.

All workmanship and materials shall conform to the standards of the District Ordinance as described in Ordinance 84-2 and 84-3 as amended. Acceptance and approval must be made by the District inspector or his duly authorized representative before backfilling and final connection is made to the main sewer lines. Any violation of applicable regulations will cause all lines and appurtenances in violation to be removed and replaced at the owners expense.

The Fall Creek Regional Waste District is responsible for the inspection, approval of materials, and installation techniques only. All costs for materials and installation and any liabilities resulting from same is the sole responsibility of the property owner.

I have read and fully understand the above provisions and agree to comply by said provisions.

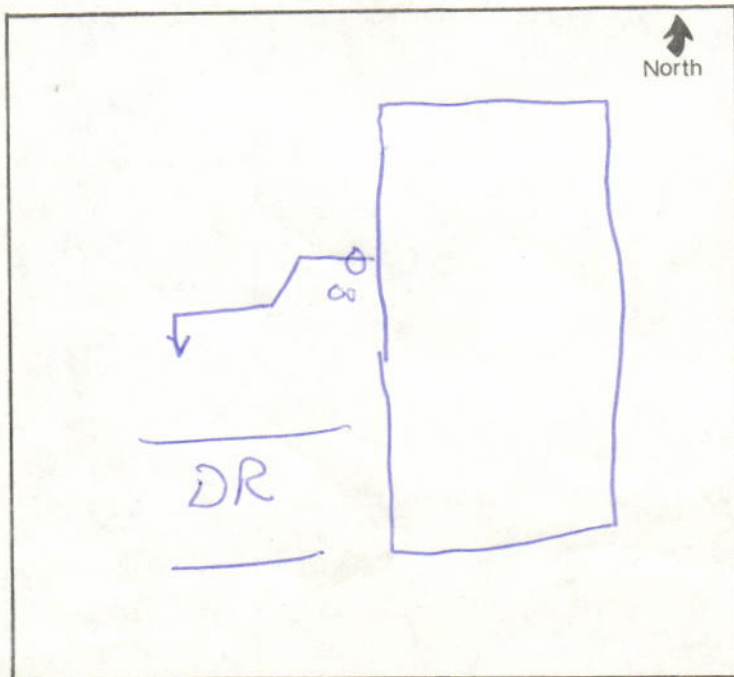
APPLICANT(S) SIGNATURE

INSPECTOR BDate inspected 7-18-90 Approved ☒ Rejected _____

Reason for rejection _____

Date reinspected _____ Approved _____ Rejected _____

Notes:

Size Pipe 6 "Type Pipe PVCBasement Yes _____ No ☒Sump Pump Yes _____ No ☒Downspout to Ground Yes ☒ No _____Septic Tank Pumped & filled Yes _____ No ☒Contractor Bob BrownSpecial Conditions New Const

To Robert Taylor Inc.
RR#1 Box 325
Daleville, IN 47334

Fall Creek Regional Waste District

P.O. Box 59 • 9378 S. 650 West
Pendleton, Indiana 46064-0059
(317) 778-3983

Subject Lot 74 - 8766 Carriage Lane

Date 5 / 17 / 90

MESSAGE

The tap and inspection fee for this lot was \$175.00 + 25.00.

You will need to remit \$25.00 as soon as possible for this property.

Signed

Teresa

5-17-90

$$500 + 25 = \$525 \quad \text{Lot } 52$$

$$500 + 25 = 525 \quad \text{Lot } 56$$

$$175 + 25 = \underline{200} \quad \text{Lot } 74$$

1250

$$CK \# 15500 = \underline{\$1225}$$

Sheet 25 Insp/Admin