






M.F.F.E.=864.1  
M.F.P.G.=863.5

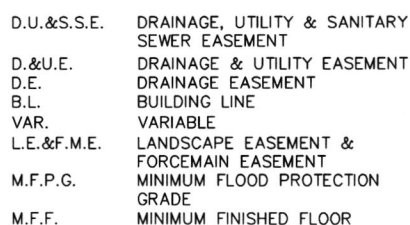

01/27/20 JCS

 **Indiana 811**


**Know what's below.  
Call before you dig.**



Springbrook Lot #10

Baldwin

N ←

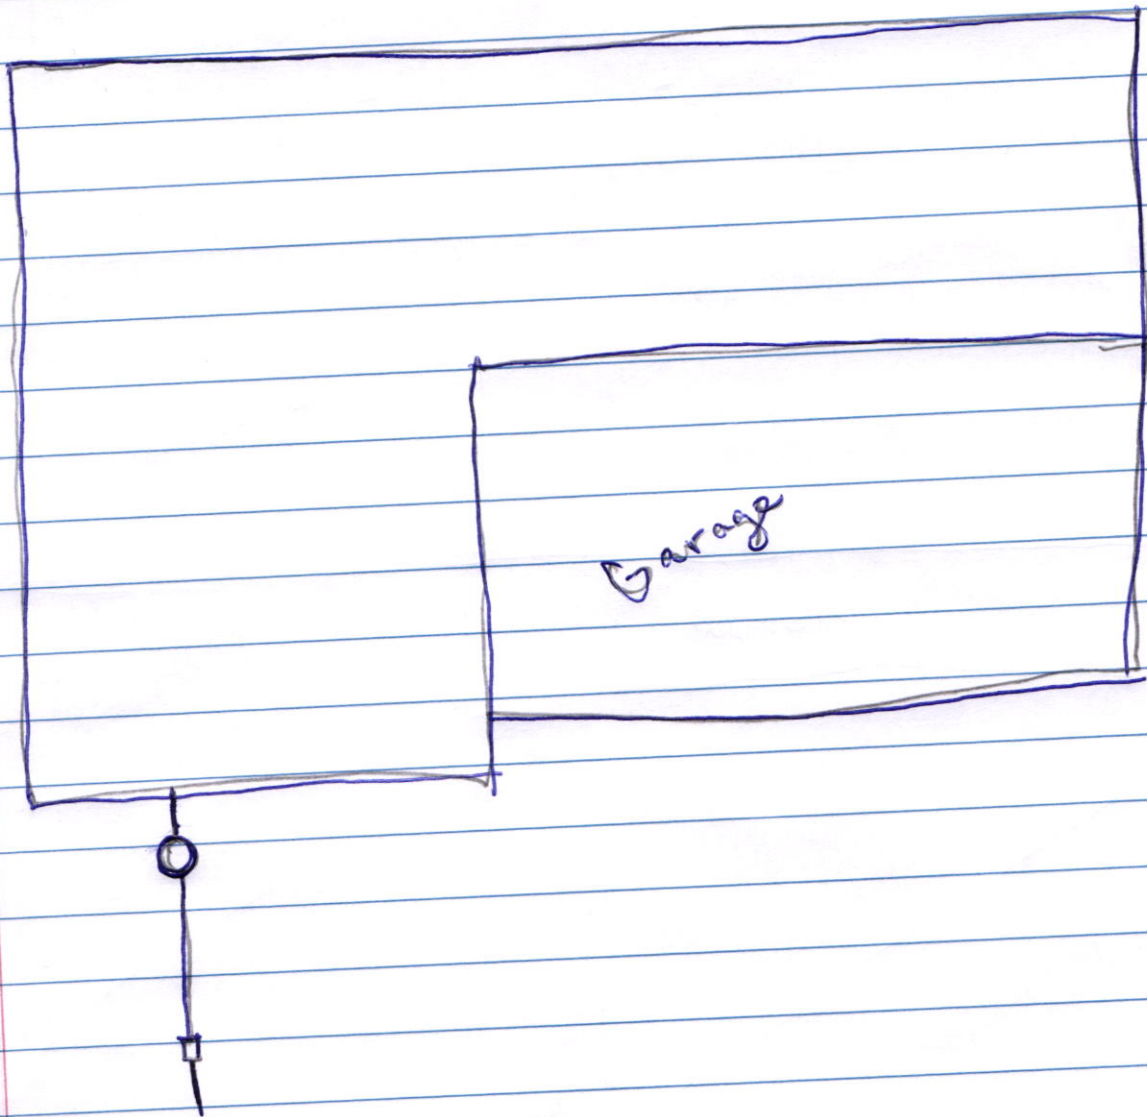


MS

8/19/10

10 #10

Spring

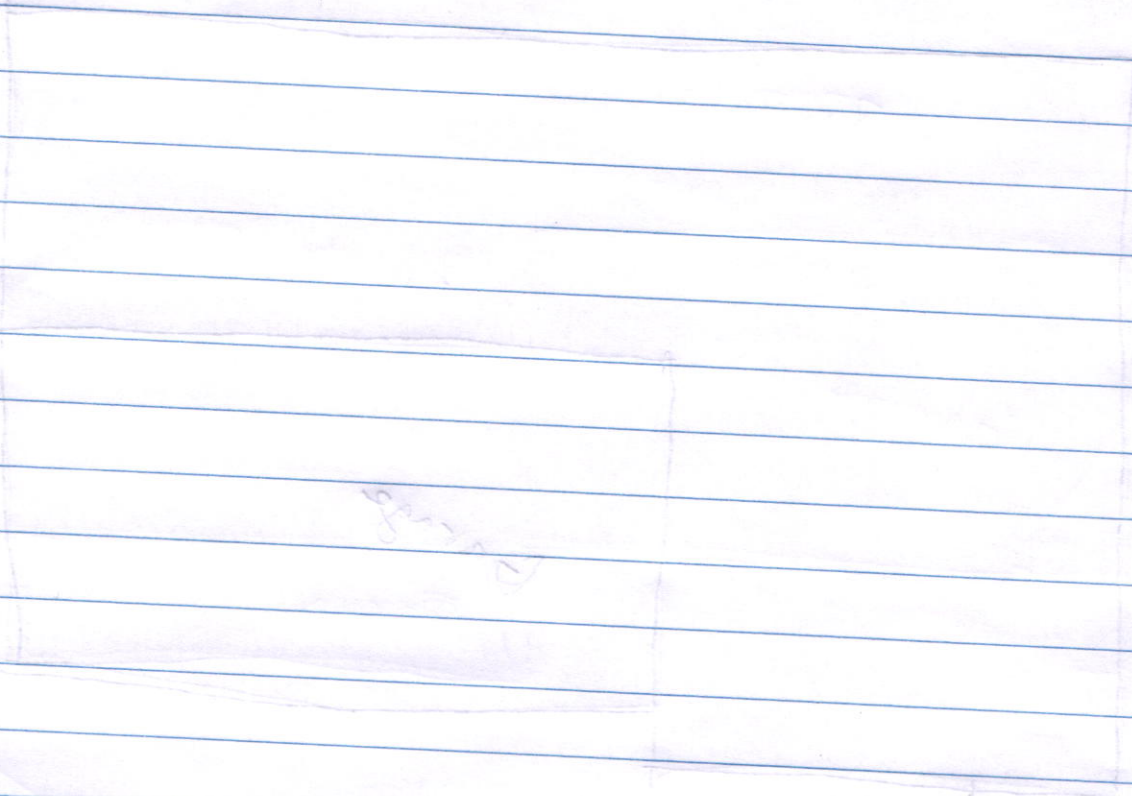

garden

0

1




8772 Winton PL

Springbrook Lot 10

Kyle Cravens

3-19-2020

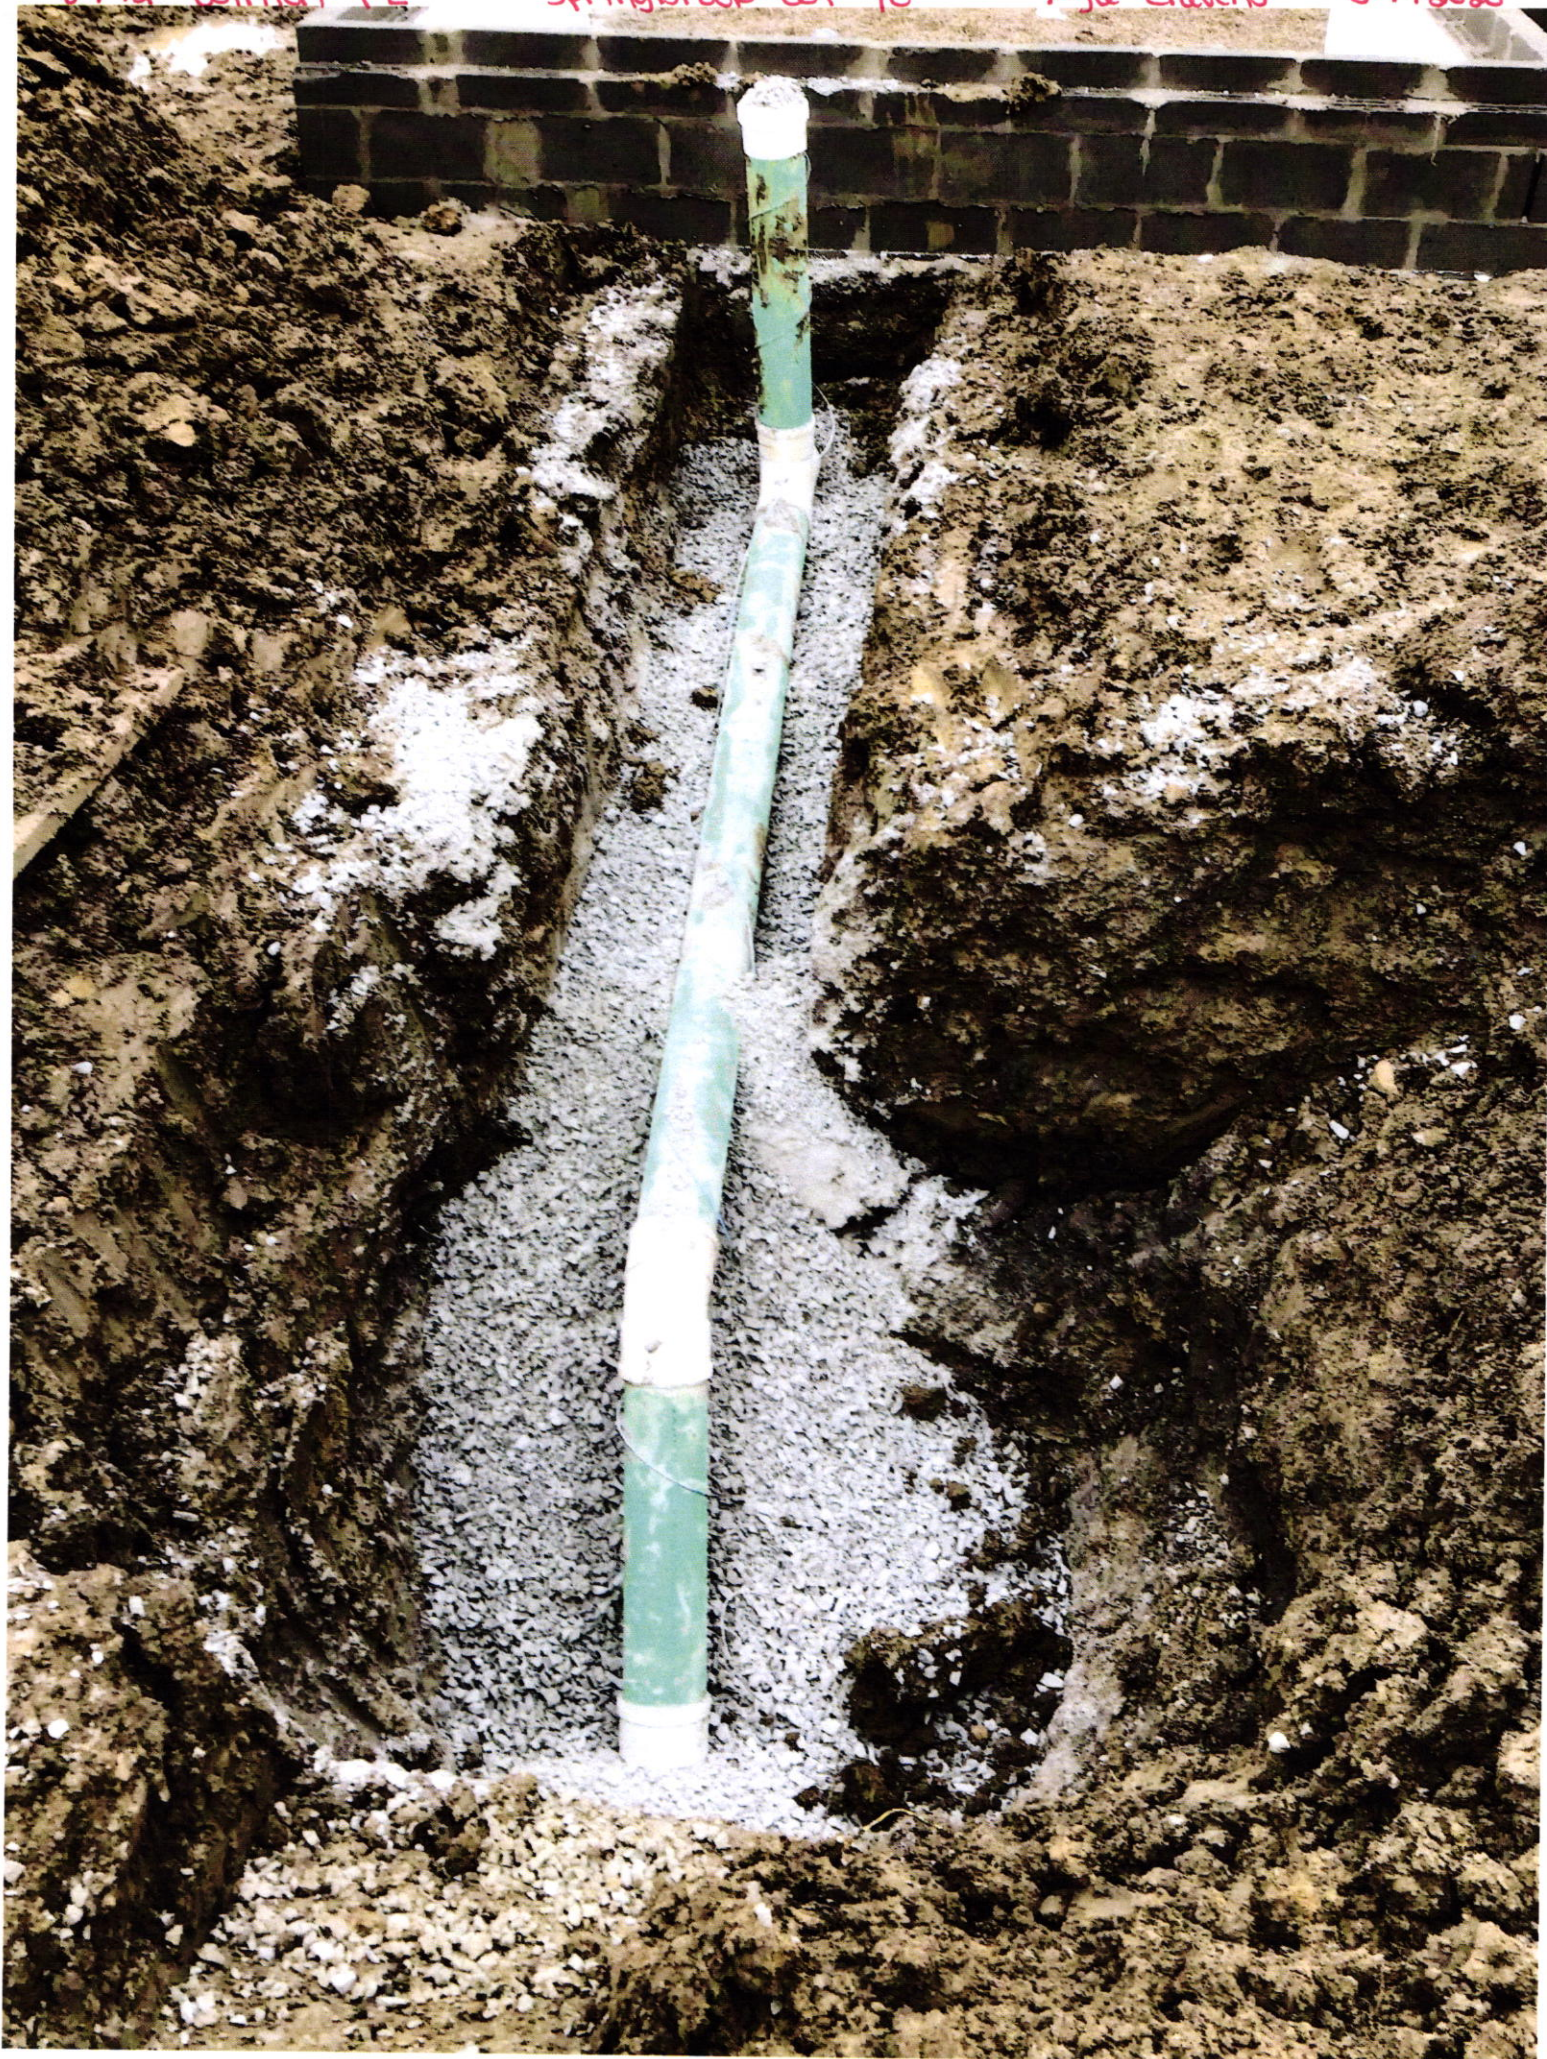



COPY

DO NOT ACCEPT THIS CHECK UNLESS YOU CAN SEE A DUAL-TONE TRUE WATERMARK THAT APPEARS AS A CHAIN LINK PATTERN WHEN HELD TO THE LIGHT. 

Lennar Homes of Indiana Inc  
9025 N River Rd Ste 100

JPMorgan Chase Bank N.A.  
Chicago, IL

01371152

Indianapolis, IN 46240

Void if over 180 days

70-2322  
719

**PAY**


DATE	AMOUNT
01/27/20	\$*****570.00

FIVE HUNDRED SEVENTY AND 00/100 \*\*\*\*\*

DOLLARS

TO  
THE  
ORDER  
OF

Fall Creek Regional Waste District  
PO Box 59  
Pendleton IN 46064

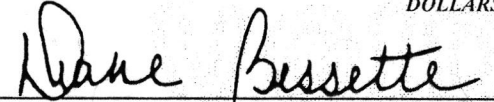  
Authorized Signatory

Authorized Signatory  
Two Signatures Required on Amounts Over \$100,000.00

THE FACE OF THIS CHECK HAS A BLUE AND GREEN BACKGROUND - ANY OTHER COLORS MAY BE EVIDENCE OF CHEMICAL ALTERATION OR ERASURE - SEE REVERSE SIDE FOR MORE SAFETY FEATURES. 