

2-000 2605.00



## FALL CREEK REGIONAL WASTE DISTRICT

Box 44, Pendleton, Indiana 46064

Walter E. Ringen III 8782 Surrey Plr.  
Ed.

Nº 001709

## APPLICATION FOR SEWER PERMIT

Permit No. \_\_\_\_\_ Date 1-3-90

Permit Void 90 days from Date of Issuance

Owner Name Robert TAYLORProperty Address Fiddlers GREENLot # 53 P.O. Box \_\_\_\_\_Town PENDLETON, IN Zip Code 46064

Phone \_\_\_\_\_ Water Meter \_\_\_\_\_

\$ 175.00 Tap on Fee Paid\$ 25.00 Inspection fee paid

Application is hereby made for connection to the Fall Creek Regional Waste District Sewer System for the above listed property - Permit Type: Residential ☒, Commercial \_\_\_\_\_, Industrial \_\_\_\_\_, or Governmental/Institutional \_\_\_\_\_. User Information \_\_\_\_\_.

All workmanship and materials shall conform to the standards of the District Ordinance as described in Ordinance 84-2 and 84-3 as amended. Acceptance and approval must be made by the District inspector or his duly authorized representative before backfilling and final connection is made to the main sewer lines. Any violation of applicable regulations will cause all lines and appurtenances in violation to be removed and replaced at the owners expense.

The Fall Creek Regional Waste District is responsible for the inspection, approval of materials, and installation techniques only. All costs for materials and installation and any liabilities resulting from same is the sole responsibility of the property owner.

I have read and fully understand the above provisions and agree to comply by said provisions.

APPLICANT(S) SIGNATURE

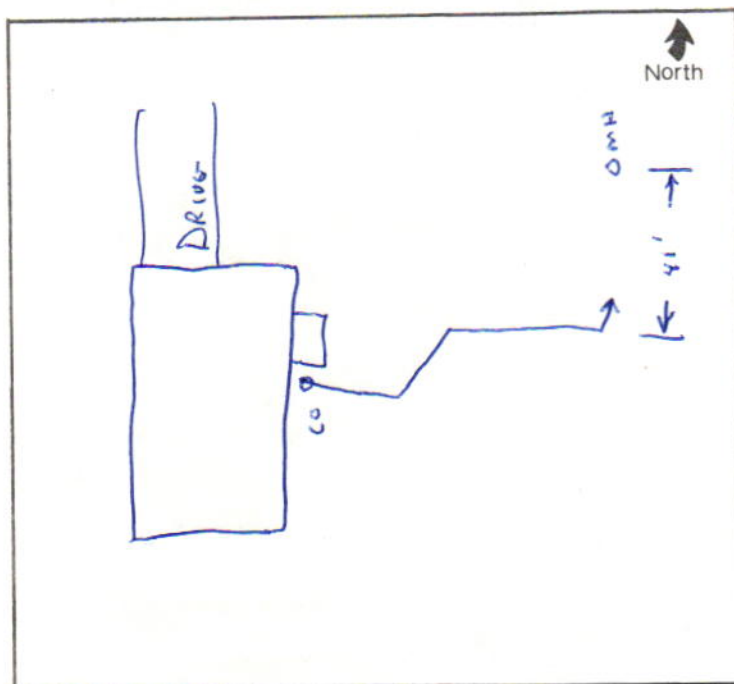
\*\*\*\*\*

INSPECTOR BenDate inspected 1-3-90 Approved ☒ Rejected \_\_\_\_\_

Reason for rejection \_\_\_\_\_

Date reinspected \_\_\_\_\_ Approved \_\_\_\_\_ Rejected \_\_\_\_\_

## Notes:

Size Pipe 6 "Type Pipe PVCBasement Yes \_\_\_\_\_ No ☒Sump Pump Yes \_\_\_\_\_ No ☒Downspout to Ground Yes ☒ No \_\_\_\_\_Septic Tank Pumped & filled Yes \_\_\_\_\_ No ☒Contractor Brown BrosSpecial Conditions New Const

44331

KINGS TITLE & ABSTRACT COMPANY

03-89

ESCROW ACCOUNT

PH. 765-643-3019  
223 W. 9TH ST., P. O. BOX 245  
ANDERSON, IN 46015-0245

August 5, 97  
DATE

71-167/749

PAY TO THE ORDER OF FALL CREEK REGIONAL WASTE \$\*\*\*\*\*71.14

Seventy-One & 14/100 Dollars\*\*\*\*\* DOLLARS

Our File # = 97-44DM



ANDERSON - ELWOOD - PENDLETON  
CARMEL - INDIANAPOLIS, INDIANA

MP

⑈044331⑈ ⑆074901672⑆

KINGS TITLE & ABSTRACT CO.  
ESCROW ACCOUNT

DETACH AND RETAIN THIS STATEMENT  
THE ATTACHED CHECK IS IN PAYMENT OF ITEMS DESCRIBED BELOW.  
IF NOT CORRECT PLEASE NOTIFY US PROMPTLY. NO RECEIPT DESIRED.

DELUXE - FORM DVCP-3 V-7

22-0260502

Our File # 97-44DM Closer : PJS Bank : FINA Legal Description:

Seller = HFS MOBILITY SERVICES  
Buyer = GARY L. HART

Lot: 53 FIDG  
FIDDLERS GREEN ADDN (ALL)  
8782 SURREY DR

Comments : PAY DEL. ASSESSMENTS

Street Address:  
8782 SURREY DR  
PENDLETON, IN 46064

CK Number= 44331 Amount= \$\*\*\*\*\*71.14