






12/07/20 JRS



**Indiana 811**

Know what's below.  
Call before you dig.

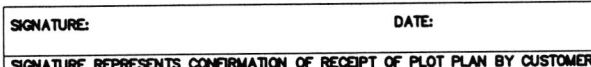


Springbrook Lot # 140

Baldwin EXU.

1/12/21

→ N

8813 Boylan Dr.

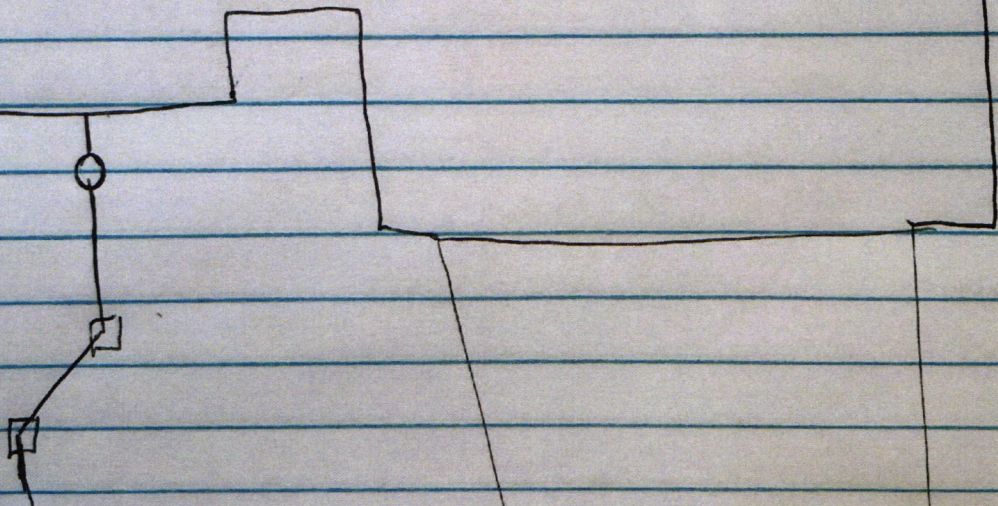





**Lennar Homes of Indiana Inc**

11555 N Meridian St Ste 400

JPMorgan Chase Bank N.A.  
Chicago, IL**01510568**


Carmel, IN 46032

Void if over 180 days

70-2322  
719**PAY**

DATE	AMOUNT
10/19/20	\$*****760.00

SEVEN HUNDRED SIXTY AND 00/100 \*\*\*\*\*

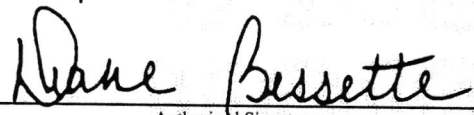**DOLLARS**TO  
THE  
ORDER  
OFFall Creek Regional Waste District  
PO Box 59  
Pendleton IN 46064  
Authorized Signatory

Rec # 011480