

Blu Falls

FALL CREEK REGIONAL WASTE DISTRICT

No 6331

9378 S 650 WEST, P.O. BOX 59, PENDLETON, IN 46064

765-778-7544

AGREEMENT FOR SANITARY SEWER SERVICE

9-20065-01

This Agreement made and entered into this 16th day of July, 2008, between FALL CREEK REGIONAL WASTE DISTRICT ("District") and Steve & Cindy Costerison ("Applicant") regarding the provision of sanitary sewer service, and the assignment of capacity in, and connection to, the District's facilities for the premises located at 8820 S. SR 9, Pendleton

NOW THEREFORE, the parties, in consideration of the mutual promises set out in this Agreement, the receipt and sufficiency of which is hereby acknowledged, agree as follows:

1. The Applicant agrees that all workmanship and materials shall conform to all District ordinances and the District's construction standards. District must accept and approve all work and materials before backfilling and final connection is made to the sewer mains. Any violation of this provision will cause all lines and appurtenances in violation to be removed and replaced at the Applicant's expense.

2. The District shall have the right to enter upon the Applicant's premises at all reasonable times to inspect, repair, or replace any equipment used in connection with the District's service or which has an impact on said service.

3. The Applicant shall be responsible for all monthly user rates, capacity charges, and tap fees. The failure to pay any rate charge or fee may result in a lien against the property and/or the termination of service to the property, the cost of which will be borne by Applicant, including, but not limited to, all attorney's fees and collection costs.

4. The District shall not be responsible for any damages as a result of any failure to supply service unless said damages are due to default, neglect or culpability on the part of the District.

5. If there is an available sanitary sewer within three hundred (300) feet of the property line, the property owner shall be required to connect to the District's sanitary sewer system.

6. The Applicant and District agree that the provision of sanitary sewer service touches and concerns the property and the terms of this Agreement bind the District and Applicant and their heirs, executors, administrators, personal representatives, successors, agents, attorneys, assigns, designees, and transferees.

The parties hereto have read and fully understand the above provisions and agree to comply with said provisions.

FALL CREEK REGIONAL WASTE DISTRICT

Signature

APPLICANT

Signature

STATE OF INDIANA)

) SS:

COUNTY OF MADISON)

SUBSCRIBED and sworn to before me this 16th day of July, 2008.

My Commission Expires April 19, 2016



A Resident of
Madison County, Indiana
Teresa K. Hutton, Notary Public

Signature

Printed

Notary Public
Resident of Madison County

INSPECTOR Don DATE INSPECTED 3.4.09 APPROVED _____ REJECTED _____

REASON FOR REJECTION _____

DATE REINSPECTED _____ APPROVED _____ REJECTED _____

NOTES:

SIZE PIPE _____ TYPE PIPE _____

BASEMENT YES _____ NO _____

SUMP PUMP YES _____ NO _____

DOWNSPOUT TO GROUND YES _____ NO _____


SEPTIC TANK PUMPED & FILLED YES _____ NO _____

CONTRACTOR _____

SPECIAL CONDITIONS _____


EXISTING HOME _____

NEW CONSTRUCTION _____

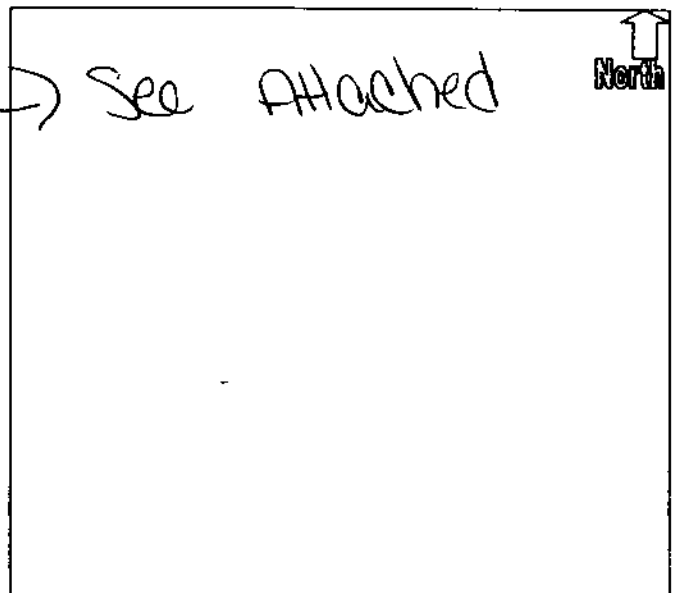



3-4-09

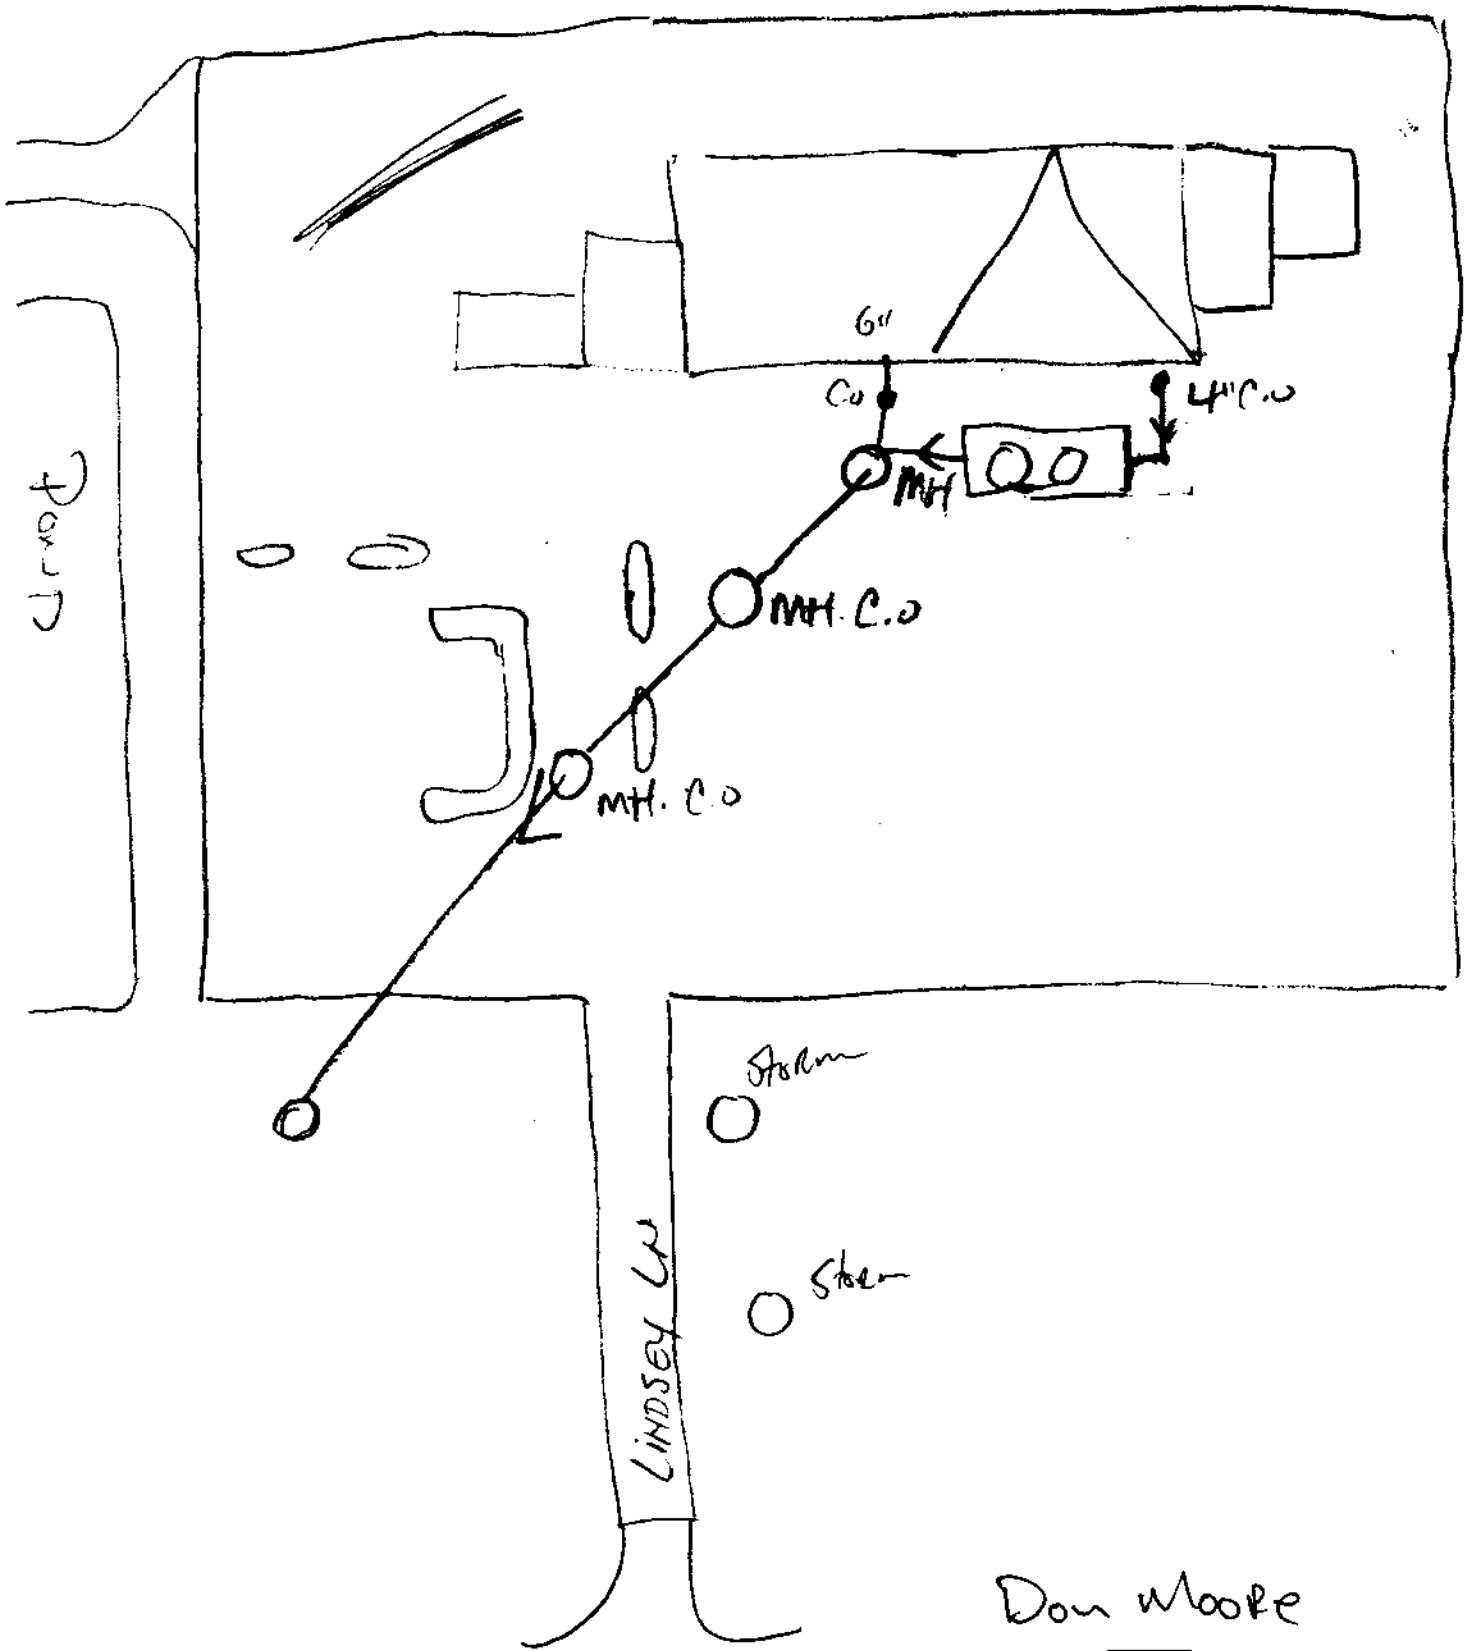



ROBERT G. TAYLOR, INC.
8880 SOUTH CR. 800 WEST
DALEVILLE, IN 47334
(765) 378-7556

FIRST MERCHANT BANK, N.A.
71-657/49
Check Number: 4672

DATE 4672
Jul 14, 2008
AMOUNT

\$ 44800.00

Memo:

PAY Forty-Four Thousand Eight Hundred and 00/100 Dollars
TO THE
ORDER
OF:

Fall Creek Regional Waste Dist
P.O. Box 59
Pendleton, IN 46064

⑈004672⑈ ⑈074900657⑈

ROBERT G. TAYLOR, INC.
Cindy L. Costumari
AUTHORIZED SIGNATURE

Security Features Included  Details on Back.

Tap \$570.00
Cap \$44230.00