Fall Creek Regional Waste District 9378 S 650 W, P.O. Box 59, Pendleton, IN 46064 765-778-7544

Agreement for Sanitary Sewer Service

#7051

provision of sanitary sewer service, and the assignment of capa facilities for the premises located at SPRINGBRO	acity in and connection to, the District's DOK LOT 28
Street Address: 8875 Sby ton St Penelles	tor, but 4100ley
Now therefore, the parties, in consideration of the mutual receipt and sufficiency of which is hereby acknowledged, agree	promises set out in this Agreement, the e as follows:
 The Applicant agrees that all workmanship and materia and the District's construction standards. District must before backfilling and final connection is made to the sprovision will cause all lines and appurtenances in viol Applicant's expense. The District shall have the right to enter upon the Applinspect, repair, or replace any equipment used in connection an impact on said service. The Applicant shall be responsible for all monthly user failure to pay any rate charge or fee may result in a lier termination of service to the property, the cost of which but not limited to, all attorney's fees and collection cost. The District shall not be responsible for any damages a unless said damages are due to default, neglect or culpated in the property owner shall be required to connect to the District. The Applicant and District agree that the provision of seconcerns the property and the terms of this Agreement heirs, executors, administrators, personal representative designees, and transferees. 	accept and approve all work and materials sewer mains. Any violation of this lation to be removed and replaced at the licant's premises at all reasonable times to ection with the District's service or which rates, capacity charges, and tap fees. The nagainst the property and/or the hail be borne by Applicant, including, sts. as a result of any failure to supply service ability on the part of the District. dred (300) feet of the property line, the rict's sanitary sewer system. sanitary sewer service touches and bind the District and Applicant and their
	1
The parties hereto have read and fully understand the above provisions.	e provisions and agree to comply with said
FALL CREEK REGIONAL WASTE DISTRICT	APPLICANTS
Signature	Simature
Signature	Signature
	Signature
Signature STATE OF INDIANA)	Signature
Signature STATE OF INDIANA) SS: COUNTY OF MADISON) SUBSCRIBED and sworn to before me this day of day of My Commission Expirescial SEAL RACHEL ELAINE ANDERSON NOTARY PUBLIC-STATE OF INDIANA MADISON COUNTY MY COMM. EXPIRES OCTOBER 23, 2021 Notation of the property of the propert	achel E. Anderson
Signature STATE OF INDIANA) SS: COUNTY OF MADISON) SUBSCRIBED and sworn to before me this day of day of My Commission Expirescial SEAL RACHEL ELAINE ANDERSON NOTARY PUBLIC-STATE OF INDIANA MADISON COUNTY MY COMM. EXPIRES OCTOBER 23, 2021 Notation of the property of the propert	Lackel E. Anderson
Signature STATE OF INDIANA) SS: COUNTY OF MADISON) SUBSCRIBED and sworn to before me this day of day of My Commission Expirescial SEAL RACHEL ELAINE ANDERSON NOTARY PUBLIC-STATE OF INDIANA MADISON COUNTY MY COMM. EXPIRES OCTOBER 23, 2021 Reserved Inspector Lac Date Inspected 30/20 Approved	Achel E. Anderson otary Public esident of Madisu County
Signature STATE OF INDIANA) SS: COUNTY OF MADISON) SUBSCRIBED and sworn to before me this day of My Commission Expirescial SEAL	Achel E. Anderson otary Public esident of Madisu County ************************************
Signature STATE OF INDIANA) SS: COUNTY OF MADISON) SUBSCRIBED and sworn to before me this day of	Achel E. Anderson otary Public esident of Madisu County ************************************
Signature STATE OF INDIANA) SS: COUNTY OF MADISON) SUBSCRIBED and sworn to before me this day of	Achel 2. Anderson otary Public esident of Madison County ***************************** Rejected Rejected Rejected
Signature STATE OF INDIANA) SS: COUNTY OF MADISON) SUBSCRIBED and sworn to before me this day of	Achel 2. Anderson otary Public esident of Madison County ***************************** Rejected Rejected Rejected
Signature STATE OF INDIANA) SS: COUNTY OF MADISON SUBSCRIBED and sworn to before me this day of	Achel 2. Anderson otary Public esident of Madison County ***************************** Rejected Rejected Rejected
Signature STATE OF INDIANA) SS: COUNTY OF MADISON) SUBSCRIBED and sworn to before me this day of	Achel 2. Anderson otary Public esident of Madison County ****************************** Rejected Rejected Rejected

NOS CENTRO SERVICE SER

、STOEPPELWERTH


7965 East 106th Street, Fishers, IN 46038-2505 phone: 317.849.5935 fax: 317.849.5942

JOB ID SPRINGBK1B.28

91815 LEN CONTROL#

1" = 30'

PARCEL #48-15-28-401-003.006-014

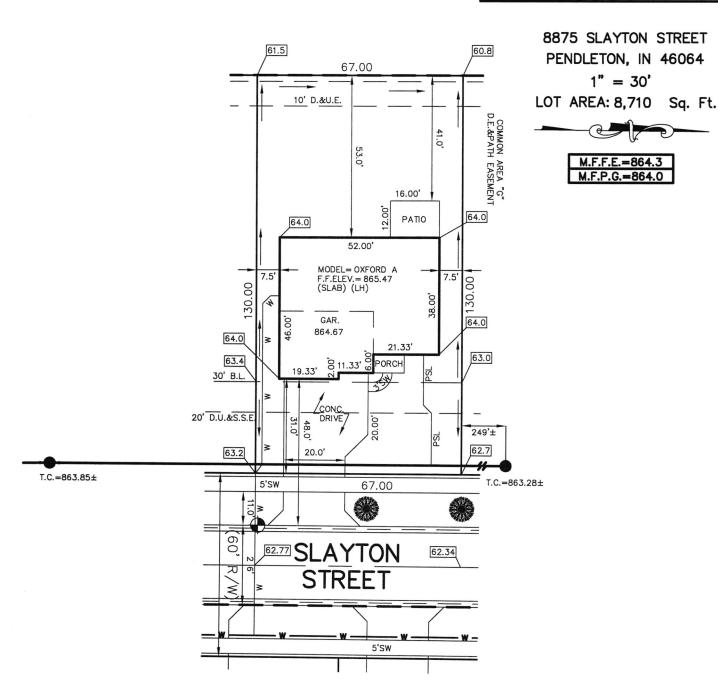

SOD: SEEDING: SEED IN EASEMENT: CONC. DRIVEWAY: PRIVATE WALK: PUBLIC WALK: APRON: ADDITIONAL SOD TO: REAR EASEMENT HANDICAP RAMPS:

589 ± Sq. Yd. 670 ± Sq. Ft. 670 ± Sq. Ft. 818 ± Sq. Ft. 26 ± Sq. Ft. 235 ± Sq. Ft. 345 ± Sq. Ft. /A ± Sq. Yd. 235 ± 345 ±

BENCHMARK TOP OF CURB = 862.77

ALL UNDERGROUND SEWERS AND UTILITIES SHOWN ARE PLOTTED BY SCALE FROM DESIGN PLANS FURNISHED BY ENGINEER THE ACTUAL FIELD LOCATION MAY VARY.

LOT 28 SPRINGBROOK SECTION 1B

INST. #2019R016779 ZONING: R3 5' MINIMUM SIDE YARD 30' MINIMUM FRONT YARD 15' MINIMUM REAR YARD LEGEND: XX.XAB

PROPOSED GRADE PER PLAN

AS BUILT GRADE

S.S.D. ASL W SWALE

- SUB-SURFACE DRAIN SANITARY SEWER 6" AS BUILT SANITARY LATERAL
6" PROPOSED SANITARY LATERAL

STORM SEWER 3/4" WATER CONNECTION WATER MAIN

SANITARY MANHOLF



STORM MANHOLE



CURB INLET FIRE HYDRANT



STREET TREES


D.U.&S.S.E.

D.&U.E. M.F.P.G. M.F.F.

DRAINAGE, UTILITY & SANITARY SEWER EASEMENT DRAINAGE & UTILITY EASEMENT BUILDING LINE MINIMUM FLOOD PROTECTION GRADE MINIMUM FINISHED FLOOR



David J. Stoeppelwerth

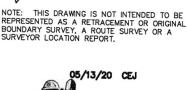



Springbrook Lot #28


7/30/20

-> N

Baldwin Exu.

Gas Line

.....

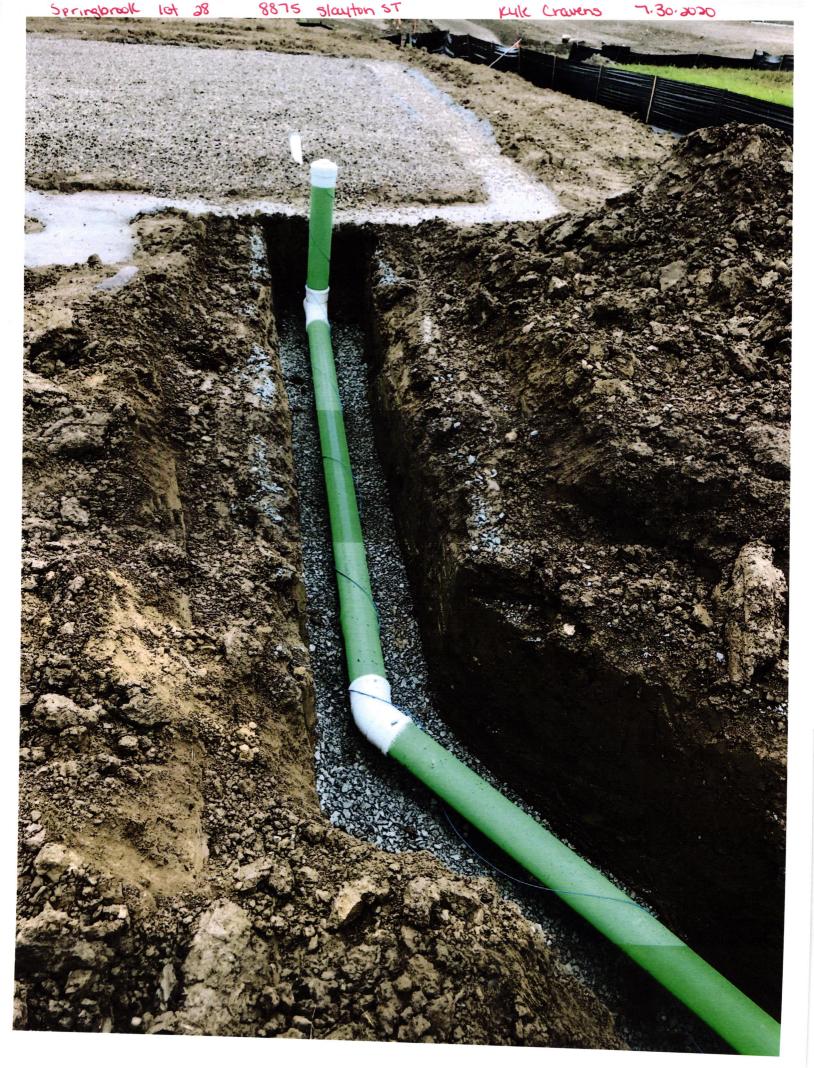



DO NOT ACCEPT THIS CHECK UNLESS YOU CAN SEE A DUAL-TONE TRUE WATERMARK THAT APPEARS AS A CHAIN LINK PATTERN WHEN HELD TO THE LIGHT. 🖺 📄

Lennar Homes of Indiana Inc 9025 N River Rd Ste 100

JPMorgan Chase Bank N.A. Chicago, IL

01428958

Indianapolis, IN 46240

Void if over 180 days

70-2322

PAY

DATE \$*****760.00 05/14/20

DOLLARS

TO THE

Fall Creek Regional Waste District

ORDER

PO Box 59

OF

Pendleton IN 46064

THE FACE OF THIS CHECK HAS A BLUE AND GREEN BACKGROUND - ANY OTHER COLORS MAY BE EVIDENCE OF CHEMICAL ALTERATION OR ERASURE - SEE REVERSE SIDE FOR MORE SAFETY FEATURES. 🖯

(cc # 011229