

FALL CREEK REGIONAL WASTE DISTRICT

9378 S 650 WEST, P.O. BOX 59, PENDLETON, IN 46064

765-778-7544

AGREEMENT FOR SANITARY SEWER SERVICE

This Agreement made and entered into this 30<sup>th</sup> day of January, 2002, between FALL CREEK REGIONAL WASTE DISTRICT ("District") and Phil Head ("Applicant") regarding the provision of sanitary sewer service, and the assignment of capacity in, and connection to, the District's facilities for the premises located at 8878 S 800 W, Pendleton

NOW THEREFORE, the parties, in consideration of the mutual promises set out in this Agreement, the receipt and sufficiency of which is hereby acknowledged, agree as follows:

1. The Applicant agrees that all workmanship and materials shall conform to all District ordinances and the District's construction standards. District must accept and approve all work and materials before backfilling and final connection is made to the sewer mains. Any violation of this provision will cause all lines and appurtenances in violation to be removed and replaced at the Applicant's expense.
2. The District shall have the right to enter upon the Applicant's premises at all reasonable times to inspect, repair, or replace any equipment used in connection with the District's service or which has an impact on said service.
3. The Applicant shall be responsible for all monthly user rates, capacity charges, and tap fees. The failure to pay any rate charge or fee may result in a lien against the property and/or the termination of service to the property, the cost of which will be borne by Applicant, including, but not limited to, all attorney's fees and collection costs.
4. The District shall not be responsible for any damages as a result of any failure to supply service unless said damages are due to default, neglect or culpability on the part of the District.
5. If there is an available sanitary sewer within three hundred (300) feet of the property line, the property owner shall be required to connect to the District's sanitary sewer system.
6. The Applicant and District agree that the provision of sanitary sewer service touches and concerns the property and the terms of this Agreement bind the District and Applicant and their heirs, executors, administrators, personal representatives, successors, agents, attorneys, assigns, designees, and transferees.

The parties hereto have read and fully understand the above provisions and agree to comply with said provisions.

FALL CREEK REGIONAL WASTE DISTRICT  
Deborah L. Wilson  
Signature

APPLICANT  
Phillip D. Head  
Signature

STATE OF INDIANA )  
                                  ) SS:  
COUNTY OF MADISON )

SUBSCRIBED and sworn to before me this 30<sup>th</sup> day of January, 2002.

My Commission Expires:  
2-20-2008

Signature Deborah L. Wilson  
Printed Deborah L. Wilson  
Notary Public  
Resident of Madison County

\*\*\*\*\*  
INSPECTOR B DATE INSPECTED 6-26-02 APPROVED ✓ REJECTED \_\_\_\_\_

REASON FOR REJECTION \_\_\_\_\_

DATE REINSPECTED \_\_\_\_\_ APPROVED \_\_\_\_\_ REJECTED \_\_\_\_\_

NOTES:  
SIZE PIPE \_\_\_\_\_ TYPE PIPE \_\_\_\_\_

BASEMENT YES \_\_\_\_\_ NO X

SUMP PUMP YES \_\_\_\_\_ NO X

DOWNSPOUT TO GROUND YES X NO \_\_\_\_\_


SEPTIC TANK PUMPED & FILLED YES \_\_\_\_\_ NO X

CONTRACTOR Tim McCurdy

SPECIAL CONDITIONS \_\_\_\_\_

EXISTING HOME \_\_\_\_\_

NEW CONSTRUCTION X

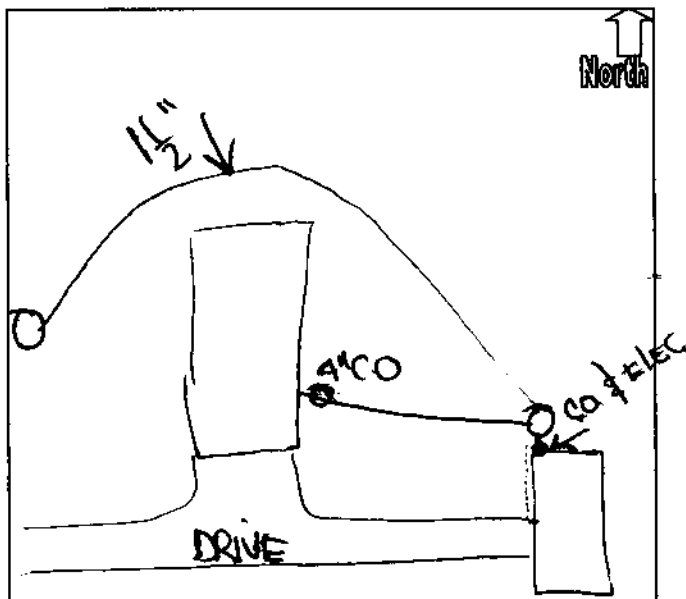

DATE	REFERENCE / INVOICE NO.	APV NUMBER	INVOICE AMOUNT	BALANCE
------	-------------------------	------------	----------------	---------

8/23/04

refund of connection fees & grinder  
per Grant Agreement \$3,580.80

Tap fee	\$400.00
Capacity Fee	\$2156.00
Grinder	\$976.00
Tax	\$48.80

THIS CHECK IS VALID ONLY WHEN USED TO PAY THE FOLLOWING

THIS AGREEMENT FOR THE  
PURPOSE OF THE  
FUNDING

FORM APPROVED BY STATE BOARD OF ACCOUNTS FOR FALL CREEK REGIONAL WASTE DISTRICT 1998

FALL CREEK REGIONAL WASTE DISTRICT

PENDLETON, INDIANA 46064

019416

DATE

8/23/04

CHECK NUMBER

19416

FUND

100

PAY EXACTLY

\*\$3,580.80\*

Three Thousand Five Hundred Eighty Dollars and 80/100\*\*

Phil Head

AMERSON COMMUNITY BANK  
PENDLETON, INDIANA

*Donlo & M. A. Lee*

TREASURER

019416 0749055391



## FALL CREEK REGIONAL WASTE DISTRICT

P.O. Box 59 • 9378 S. 650 West • Pendleton, Indiana 46064-0059 • (765) 778-7544

---

August 23, 2004

Mr. Phil Head  
8878 S 800 W  
Pendleton, IN 46064

Dear Mr. Head:

Recently the Fall Creek Regional Waste District (FCRWD) was pleased to announce that a Community Focus Fund Grant has been awarded to the Town of Ingalls with FCRWD as a sub recipient by the Indiana Department of Commerce to fund construction of a wastewater collection system for the areas of Green Township known as County Roads 650 West, 750 West, 760 West, 900 South, 920 South, 800 West, 800 South, 875 South, Fall Creek Drive (between CR 650 W and CR 750 W), and Carefree Community Homes.

As Fall Creek Regional Waste District promised and as a result of the grant, residents in these areas will not be charged any connection fees and will be provided a residential wastewater grinder unit at no cost when they connect their homes to the sanitary system.

Enclosed please find a check in the amount of \$3,580.80 as reimbursement of your connection fees and the cost of your wastewater grinder unit.

Thank you for your support of our successful grant efforts.

Sincerely,

Teresa K. Hutton  
Office Manager