

Fall Creek Regional Waste District
9378 S 650 W, P.O. Box 59, Pendleton, IN 46064
765-778-7544

#7052

Agreement for Sanitary Sewer Service

This Agreement made and entered into this 27 day of May, 2020, between Fall Creek Regional Waste District ("District") and LENNAR HOMES ("Applicant") regarding the provision of sanitary sewer service, and the assignment of capacity in and connection to, the District's facilities for the premises located at SPRINGBROOK LOT 29.

Street Address: 8889 Skayton St. Pendleton, IN 46064

Now therefore, the parties, in consideration of the mutual promises set out in this Agreement, the receipt and sufficiency of which is hereby acknowledged, agree as follows:

1. The Applicant agrees that all workmanship and materials shall conform to all District ordinances and the District's construction standards. District must accept and approve all work and materials before backfilling and final connection is made to the sewer mains. Any violation of this provision will cause all lines and appurtenances in violation to be removed and replaced at the Applicant's expense.
2. The District shall have the right to enter upon the Applicant's premises at all reasonable times to inspect, repair, or replace any equipment used in connection with the District's service or which has an impact on said service.
3. The Applicant shall be responsible for all monthly user rates, capacity charges, and tap fees. The failure to pay any rate charge or fee may result in a lien against the property and/or the termination of service to the property, the cost of which will be borne by Applicant, including, but not limited to, all attorney's fees and collection costs.
4. The District shall not be responsible for any damages as a result of any failure to supply service unless said damages are due to default, neglect or culpability on the part of the District.
5. If there is an available sanitary sewer within three hundred (300) feet of the property line, the property owner shall be required to connect to the District's sanitary sewer system.
6. The Applicant and District agree that the provision of sanitary sewer service touches and concerns the property and the terms of this Agreement bind the District and Applicant and their heirs, executors, administrators, personal representatives, successors, agents, attorneys, assigns, designees, and transferees.

The parties hereto have read and fully understand the above provisions and agree to comply with said provisions.

FALL CREEK REGIONAL WASTE DISTRICT

Signature

APPLICANT


Signature

STATE OF INDIANA)

) SS:

COUNTY OF MADISON)

SUBSCRIBED and sworn to before me this 27 day of May, 2020

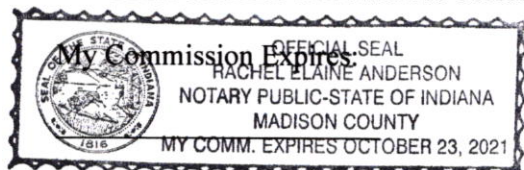

Signature

Printed

Notary Public

Resident of Madison County

Inspector Kyle Date Inspected 7/31/20 Approved ✓ Rejected _____

Reason for Rejection _____

Date Reinspected _____ Approved _____ Rejected _____

Notes:

Size Pipe 6" Type Pipe SDR 35

Basement Yes (No)

Sump Pump Yes (No)

Downspout to Ground Yes (No)


Septic Tank Pumped & Filled Yes (No)

Contractor Baldwin EXU.

Special Conditions _____

Existing Home _____

New Construction ✓

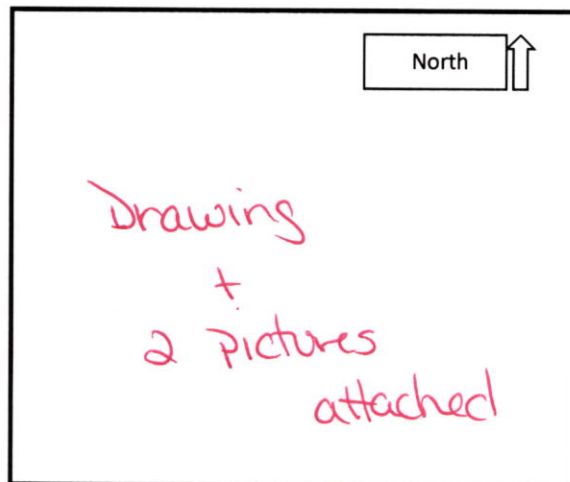



7965 East 106th Street, Fishers, IN 46038-2505
phone: 317.849.5935 fax: 317.849.5942

CONTROL# 91816 LEN

8889 SLAYTON STREET
PENDLETON, IN 46064

LOT AREA: 8,710 Sq. Ft.

05/13/20 CEJ


 **Indiana 811**

Know what's below.
Call before you dig.

Springbrook Lot 29

7/31/20

→N

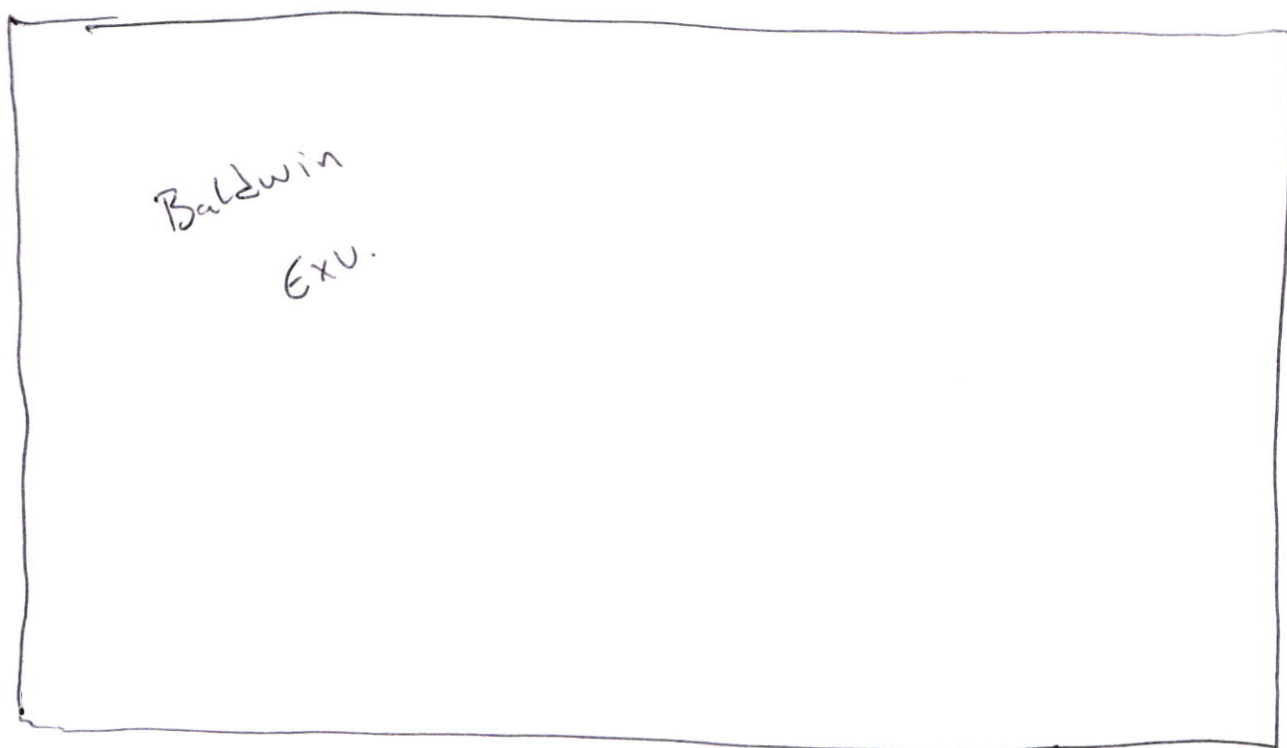

Gas Main

Springbrook lot 29

8889

slayton st

Kyle Cravens

7.31.2020



Springbrook lot 29

8889 Slayton ST

Kyle Cravens 7.31.2020



Lennar Homes of Indiana Inc

9025 N River Rd Ste 100

Indianapolis, IN 46240


JPMorgan Chase Bank N.A.
Chicago, IL**01428959**70-2322
719

Void if over 180 days

DATE	AMOUNT
05/14/20	\$*****760.00

PAY

SEVEN HUNDRED SIXTY AND 00/100 *****

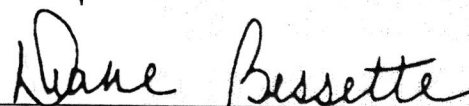DOLLARSTO
THE
ORDER
OFFall Creek Regional Waste District
PO Box 59
Pendleton IN 46064

Authorized Signatory

Rec # 011230