Fall Creek Regional Waste District 9378 S 650 W, P.O. Box 59, Pendleton, IN 46064 765-778-7544

Agreement for Sanitary Sewer Service

117	7 1	$\overline{}$	1
#	/ I	- /	
11 1			1

This Agreement made and entered into this day of day of Regional Waste District ("District") and LENNAR HOMES provision of sanitary sewer service, and the assignment of cap facilities for the premises located at Springbrook Lot 126	pacity in and connection to, the District's
Street Address: 8890 Boylan	PL
Now therefore, the parties, in consideration of the mutual receipt and sufficiency of which is hereby acknowledged, agr	al promises set out in this Agreement, the
 The Applicant agrees that all workmanship and mater and the District's construction standards. District must before backfilling and final connection is made to the provision will cause all lines and appurtenances in vio Applicant's expense. 	st accept and approve all work and materials sewer mains. Any violation of this
 The District shall have the right to enter upon the Applinspect, repair, or replace any equipment used in conthas an impact on said service. 	plicant's premises at all reasonable times to nection with the District's service or which
 The Applicant shall be responsible for all monthly use failure to pay any rate charge or fee may result in a lie termination of service to the property, the cost of which 	en against the property and/or the ch will be borne by Applicant, including,
 but not limited to, all attorney's fees and collection co 4. The District shall not be responsible for any damages unless said damages are due to default, neglect or culp 5. If there is an available sanitary sewer within three hur 	as a result of any failure to supply service pability on the part of the District.
 property owner shall be required to connect to the Dis 6. The Applicant and District agree that the provision of concerns the property and the terms of this Agreemen heirs, executors, administrators, personal representative 	strict's sanitary sewer system. Sanitary sewer service touches and their thind the District and Applicant and their
designees, and transferees. The parties hereto have read and fully understand the abo	ve provisions and agree to comply with said
provisions.	
FALL CREEK REGIONAL WASTE DISTRICT	APPLICANT
Signature	Signature
STATE OF INDIANA)) SS:	
COUNTY OF MADISON)	
SUBSCRIBED and sworn to before me this day of _	, 20
My Commission Expires: Signature_	
Printed	
<u></u>	Notary Public
***************	Resident of County
Inspector Don Date Inspected 45-21 Approved	Rejected
Reason for Rejecton Approved_	nejecteu
Date Reinspected Approved_	Rejected
Notes: 64 Type Pipe Pic 35	
Basement Yes No	North
Sump Pump Yes No	
Downspout to Ground <u>Yes No</u> Septic Tank Pumped & Filled <u>Yes No</u>	
Contractor Contractor	
Special Conditions	1
Existing Home	
New Construction	



STOEPPELWERTH

7965 East 106th Street, Fishers, IN 46038-2505 phone: 317.849.5935 fax: 317.849.5942

JOB ID SPRINGBK3.126

CONTROL# 95600 LEN

PARCEL# N/A

8890 BOYLAN PLACE PENDLETON, IN 46064



1" = 30'

LOT AREA: 8,710 Sq. Ft.

> M.F.F.E.=864.0 M.F.P.G.=863.8

LEGEND: XX.XAB

PROPOSED GRADE PER PLAN

AS BUILT GRADE

S.S.D. — SUB-SURFACE DRAIN ASL W W

SANITARY SEWER 6" AS BUILT SANITARY LATERAL 6" PROPOSED SANITARY LATERAL STORM SEWER

3/4" WATER CONNECTION WATER MAIN

SWALE

SANITARY MANHOLE



STORM MANHOLE



CURB INLET



FIRE HYDRANT



EMERGENCY FLOOD ROUTE




STREET TREE

D.U.&S.S.E. D.&U.E. B.L.

DRAINAGE, UTILITY & SANITARY SEWER EASEMENT DRAINAGE & UTILITY EASEMENT

M.F.F.E. M.F.P.G. BUILDING LINE

MINIMUM FINISHED FLOOR
ELEVATION
MINIMUM FLOOD PROTECTION
GRADE

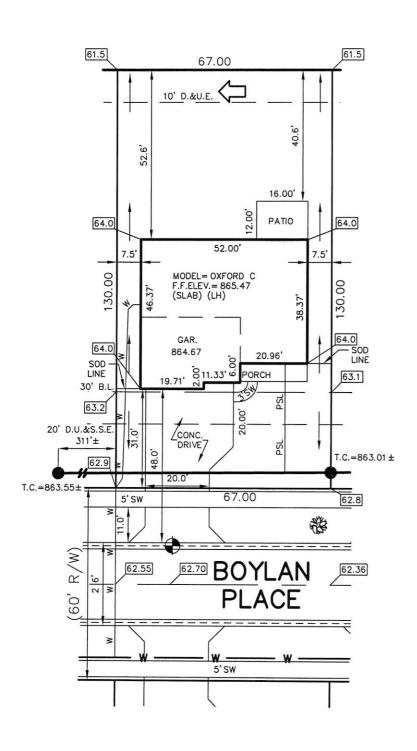

ALL UNDERGROUND SEWERS AND UTILITIES SHOWN ARE PLOTTED BY SCALE FROM DESIGN PLANS FURNISHED BY ENGINEER THE ACTUAL FIELD LOCATION MAY VARY.

LOT 126 SPRINGBROOK SECTION INST. #2020R017818 ZONING: R3

5' MINIMUM SIDE YARD 30' MINIMUM FRONT YARD 15' MINIMUM REAR YARD

BENCHMARK TOP OF CURB = 862.70

SOD: SEEDING: SEED IN EASEMENT: CONC. DRIVEWAY: PRIVATE WALK:
PUBLIC WALK:
APRON:
TONAL SOD TO: ADDITIONAL SOD REAR EASEMENT HANDICAP RAMPS:

214 ± Sq. Yd. 3,970 ± Sq. Ft. 670 ± Sq. Ft. 817 ± Sq. Ft. 27 ± Sq. Ft. 235 ± Sq. Ft. 345 ± 367 ± 0


SIGNATURE: DATE: SIGNATURE REPRESENTS CONFIRMATION OF RECEIPT OF PLOT PLAN BY CUSTOMER



David

NOTE: THIS DRAWING IS NOT INTENDED TO BE REPRESENTED AS A RETRACEMENT OR ORIGINAL BOUNDARY SURVEY, A ROUTE SURVEY OR A SURVEYOR LOCATION REPORT.



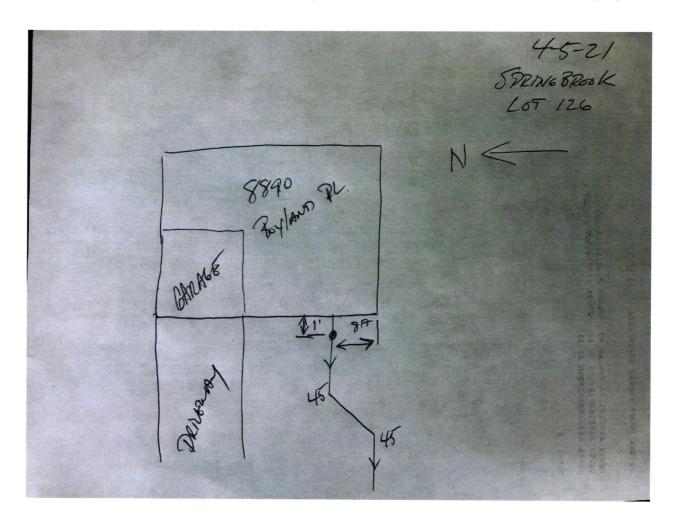



Fall Const. Reviews I West Division				j -
12975753 Fall Creek Regional Waste District	PO Box 59 Pendleton IN 46064	\$760.00	\$0.00	\$760.00

DO NOT ACCEPT THIS CHECK UNLESS YOU CAN SEE A DUAL-TONE TRUE WATERMARK THAT APPEARS AS A CHAIN LINK PATTERN WHEN HELD TO THE LIGHT. 🟦

Lennar Homes of Indiana Inc

11555 N Meridian St Ste 400

JPMorgan Chase Bank N.A. Chicago, IL

01548019

Carmel, IN 46032

Void if over 180 days

7.0-2322 719

DATE 01/04/21

AMOUNT \$******760.00

SEVEN HUNDRED SIXTY AND 00/100 ******************************

DOLLARS

TO THE

PAY

Fall Creek Regional Waste District

ORDER PO Box 59

OF Pendleton IN 46064

Lyane Bessett

THE FACE OF THIS CHECK HAS A BLUE AND GREEN BACKGROUND - ANY OTHER COLORS MAY BE EVIDENCE OF CHEMICAL ALTERATION OR ERASURE - SEE REVERSE SIDE FOR MORE SAFETY FEATURES.

#11551