

22-02325.00 add order
on file



FALL CREEK REGIONAL WASTE DISTRICT

9378 S. 650 West PO Box 59
Pendleton, IN 46064-0059 778-7544

APPLICATION FOR SEWER PERMIT

Nº 2663

Date 12/15/98

Permit Void 90 days from Date of Issuance

Owner Name John Pryor

Property Address 8901 Carriage Lane

Lot # _____ P.O. Box _____

Town Pendleton, IN Zip Code 46064

Phone _____ City Water _____ Well ☒

\$ 400 Tap on Fee Paid 1/25/99

\$ 2156 ~~Inspection~~ Capacity fee paid 2/25/99

Application is hereby made for connection to the Fall Creek Regional Waste District Sewer System for the above listed property - Permit Type: Residential _____, Commercial _____, Industrial _____, or Governmental/Institutional _____. User Information _____.

All workmanship and materials shall conform to the standards of the District Ordinance as described in Ordinance 84-2 and 84-3 as amended. Acceptance and approval must be made by the District inspector or his duly authorized representative before backfilling and final connection is made to the main sewer lines. Any violation of applicable regulations will cause all lines and appurtenances in violation to be removed and replaced at the owners expense.

The Fall Creek Regional Waste District is responsible for the inspection, approval of materials, and installation techniques only. All costs for materials and installation and any liabilities resulting from same is the sole responsibility of the property owner.

I have read and fully understand the above provisions and agree to comply by said provisions.

APPLICANT(S) SIGNATURE

INSPECTOR Bea

Date inspected 12-14-98 Approved ☒ Rejected _____

Reason for rejection _____

Date reinspected _____ Approved _____ Rejected _____

Notes:

Size Pipe 6"

Type Pipe PVC

Basement Yes _____ No ☒

Sump Pump Yes _____ No ☒

Downspout to Ground Yes ☒ No _____


Septic Tank Pumped & filled Yes _____ No ☒

Contractor Self

Special Conditions _____

Existing Home _____

New Construction ☒

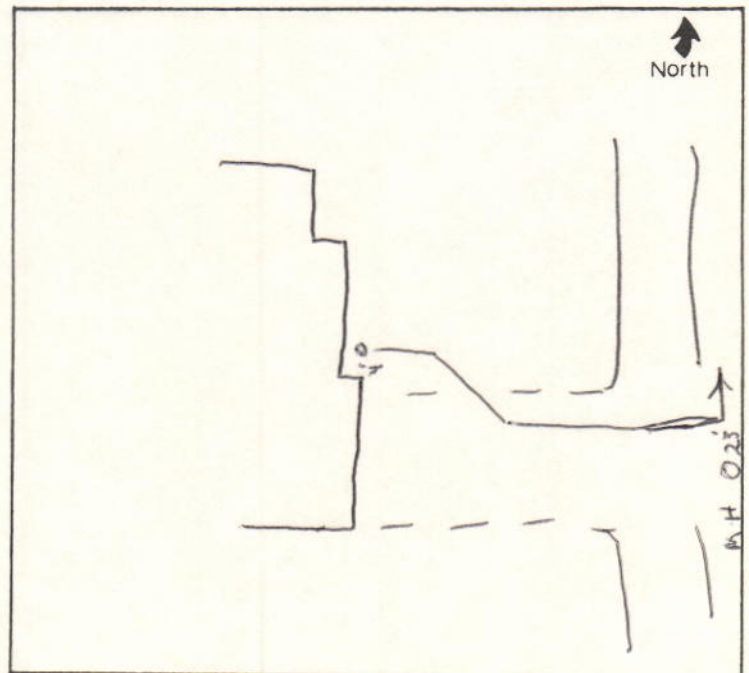



FALL CREEK REGIONAL WASTE DISTRICT

P.O. Box 59 • 9378 S. 650 West • Pendleton, Indiana 46064-0059 • (765) 778-7544

February 10, 1999

Mr. John Pryor
8901 Carriage Lane
Pendleton, IN 46064

RE: Tap & Capacity Fees


Dear Mr. Pryor:

You recently connected your home at 8901 Carriage Lane to Fall Creek Regional Waste District's sewer system. Please accept this letter as billing for the tap & capacity fees that are due for 8901 Carriage Lane, Pendleton.

Tap Fee	Capacity Fee	Total
\$400	\$2156	\$2556

TOTAL AMOUNT DUE: \$2556

If you have any questions, please give us a call at 778-7544.


J.F. Rowlett
General Manager

JFR/dlw