

**Fall Creek Regional Waste District**  
9378 S 650 W, P.O. Box 59, Pendleton, IN 46064  
765-778-7544

#7192

**Agreement for Sanitary Sewer Service**

This Agreement made and entered into this 25 day of Feb, 2021, between Fall Creek Regional Waste District ("District") and LENNAR HOMES ("Applicant") regarding the provision of sanitary sewer service, and the assignment of capacity in and connection to, the District's facilities for the premises located at Springbrook Lot 147.

Street Address: 8915 Boyan Place

**Now therefore**, the parties, in consideration of the mutual promises set out in this Agreement, the receipt and sufficiency of which is hereby acknowledged, agree as follows:


1. The Applicant agrees that all workmanship and materials shall conform to all District ordinances and the District's construction standards. District must accept and approve all work and materials before backfilling and final connection is made to the sewer mains. Any violation of this provision will cause all lines and appurtenances in violation to be removed and replaced at the Applicant's expense.
2. The District shall have the right to enter upon the Applicant's premises at all reasonable times to inspect, repair, or replace any equipment used in connection with the District's service or which has an impact on said service.
3. The Applicant shall be responsible for all monthly user rates, capacity charges, and tap fees. The failure to pay any rate charge or fee may result in a lien against the property and/or the termination of service to the property, the cost of which will be borne by Applicant, including, but not limited to, all attorney's fees and collection costs.
4. The District shall not be responsible for any damages as a result of any failure to supply service unless said damages are due to default, neglect or culpability on the part of the District.
5. If there is an available sanitary sewer within three hundred (300) feet of the property line, the property owner shall be required to connect to the District's sanitary sewer system.
6. The Applicant and District agree that the provision of sanitary sewer service touches and concerns the property and the terms of this Agreement bind the District and Applicant and their heirs, executors, administrators, personal representatives, successors, agents, attorneys, assigns, designees, and transferees.

The parties hereto have read and fully understand the above provisions and agree to comply with said provisions.

FALL CREEK REGIONAL WASTE DISTRICT  
Rachel E. Anderson  
Signature

APPLICANT  
[Signature]  
Signature

STATE OF INDIANA )  
                                  ) SS:  
COUNTY OF MADISON )

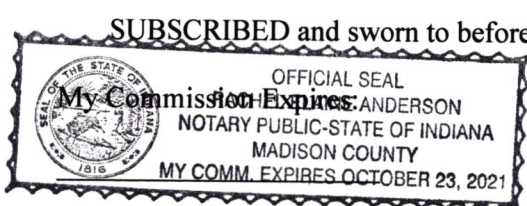

SUBSCRIBED and sworn to before me this 25 day of Feb, 2021  
Signature Rachel E. Anderson  
Printed Rachel E. Anderson  
Notary Public  
Resident of Madison County


\*\*\*\*\*


Inspector Sam Date Inspected 6-4-21 Approved X Rejected \_\_\_\_\_  
Reason for Rejection \_\_\_\_\_

Date Reinspected \_\_\_\_\_ Approved \_\_\_\_\_ Rejected \_\_\_\_\_

Notes:

Size Pipe 6 Type Pipe 36  
Basement Yes No  
Sump Pump Yes No  
Downspout to Ground Yes No  
Septic Tank Pumped & Filled Yes No  
Contractor Baldin Ex  
Special Conditions \_\_\_\_\_  
Existing Home \_\_\_\_\_  
New Construction X

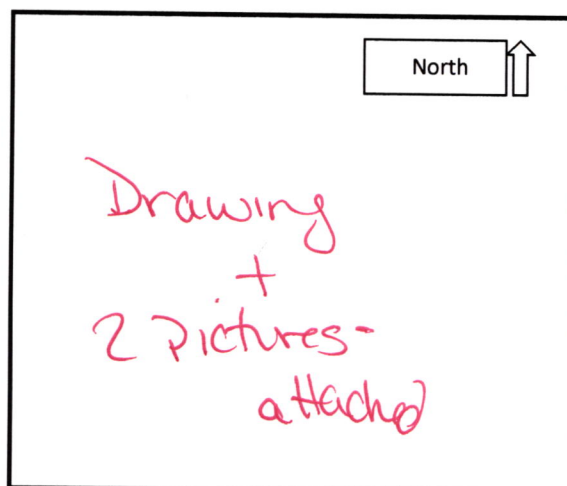

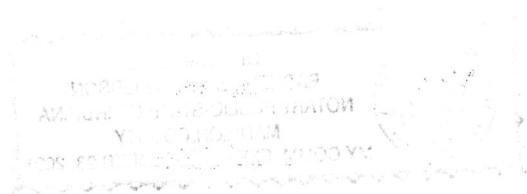



# STOEPPELWERTH

ALWAYS ON

7965 East 106th Street, Fishers, IN 46038-2505

phone: 317.849.5935 fax: 317.849.5942

LAKE #3  
N.P. ELEV.=852.00  
100 YEAR ELEV.=855.14

JOB ID SPRINGBK3.147

CONTROL# 96395 LEN

PARCEL# N/A


8915 BOYLAN PLACE  
PENDLETON, IN 46064

1" = 30'

LOT AREA: 8,710 Sq. Ft.

M.F.F.E.=864.0

M.F.P.G.=863.8

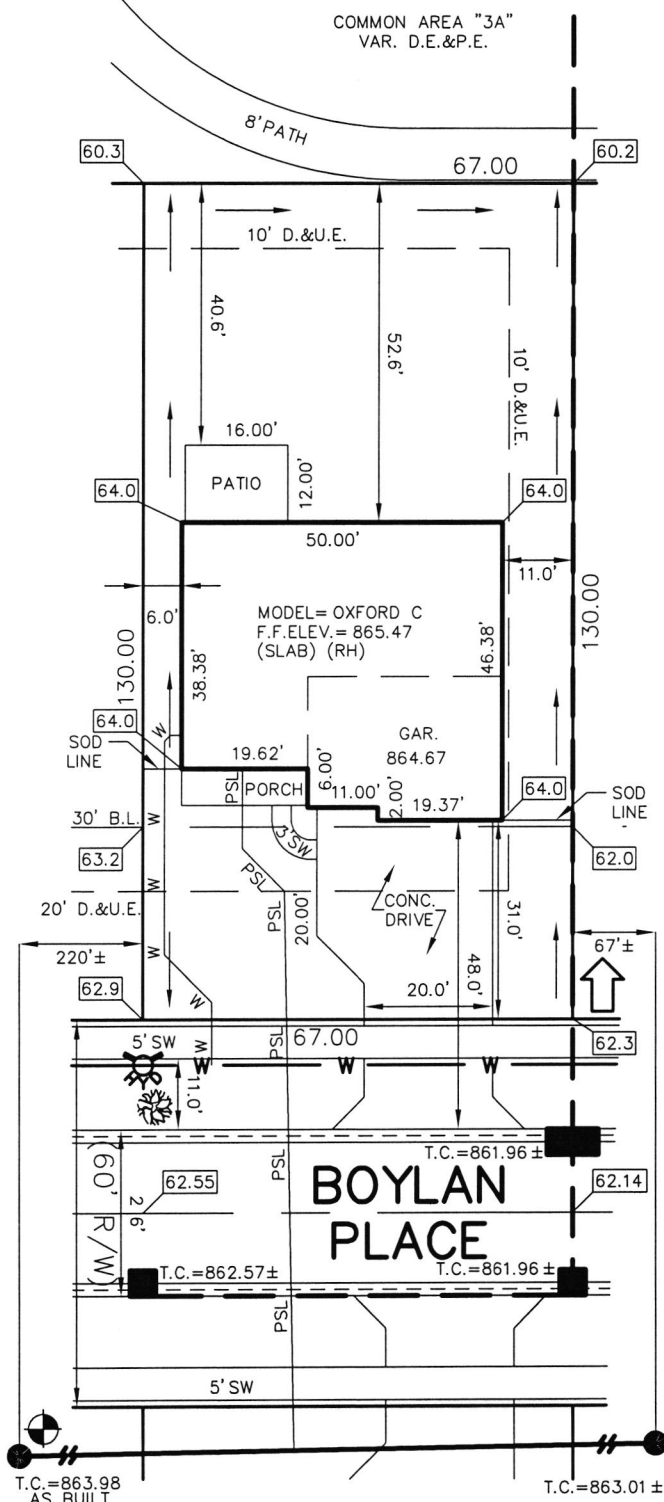

#### LEGEND:

- XX.X PROPOSED GRADE PER PLAN
- XX.XAB AS BUILT GRADE
- S.S.D. SUB-SURFACE DRAIN
- ASL SANITARY SEWER
- PSL 6" AS BUILT SANITARY LATERAL
- PSL 6" PROPOSED SANITARY LATERAL
- W STORM SEWER
- W 3/4" WATER CONNECTION
- W WATER MAIN
- SW SWALE
- SANITARY MANHOLE
- STORM MANHOLE
- CURB INLET
- FIRE HYDRANT
- STREET TREE
- WV WATER VALVE
- EMERGENCY FLOOD ROUTE
- D.E.&P.E. DRAINAGE & LANDSCAPE EASEMENT
- D.&U.E. DRAINAGE & UTILITY EASEMENT
- B.L. BUILDING LINE
- VAR. VARIABLE
- M.F.F.E. MINIMUM FINISHED FLOOR ELEVATION
- M.F.P.G. MINIMUM FLOOD PROTECTION GRADE



*David J. Stoepfelwerth*

NOTE: THIS DRAWING IS NOT INTENDED TO BE REPRESENTED AS A RETRACEMENT OR ORIGINAL BOUNDARY SURVEY, A ROUTE SURVEY OR A SURVEYOR LOCATION REPORT.

ALL UNDERGROUND SEWERS AND UTILITIES SHOWN ARE PLOTTED BY SCALE FROM DESIGN PLANS FURNISHED BY ENGINEER. THE ACTUAL FIELD LOCATION MAY VARY.

#### BENCHMARK

TOP OF CASTING 863.98

SOD:	211 ± Sq. Yd.
SEEDING:	4,074 ± Sq. Ft.
SEED IN EASEMENT:	670 ± Sq. Ft.
CONC. DRIVEWAY:	819 ± Sq. Ft.
PRIVATE WALK:	31 ± Sq. Ft.
PUBLIC WALK:	235 ± Sq. Ft.
APRON:	345 ± Sq. Ft.
ADDITIONAL SOD TO:	378 ± Sq. Yd.
REAR EASEMENT	
HANDICAP RAMPS:	0

SIGNATURE:

DATE:

SIGNATURE REPRESENTS CONFIRMATION OF RECEIPT OF PLOT PLAN BY CUSTOMER

LOT 147  
SPRINGBROOK  
SECTION 3

INST. #2020R017818

ZONING: R3

5' MINIMUM SIDE YARD  
30' MINIMUM FRONT YARD  
15' MINIMUM REAR YARD

02/15/21 NSH





# STOEPPELWERTH

ALWAYS ON

7965 East 106th Street, Fishers, IN 46038-2505  
phone: 317.849.5935 fax: 317.849.5942

JOB ID SPRINGBK3.147


CONTROL# 96395 LEN

8915 BOYLAN PLACE  
PENDLETON, IN 46064



1" = 40'

LOT AREA: 8,710 Sq. Ft.

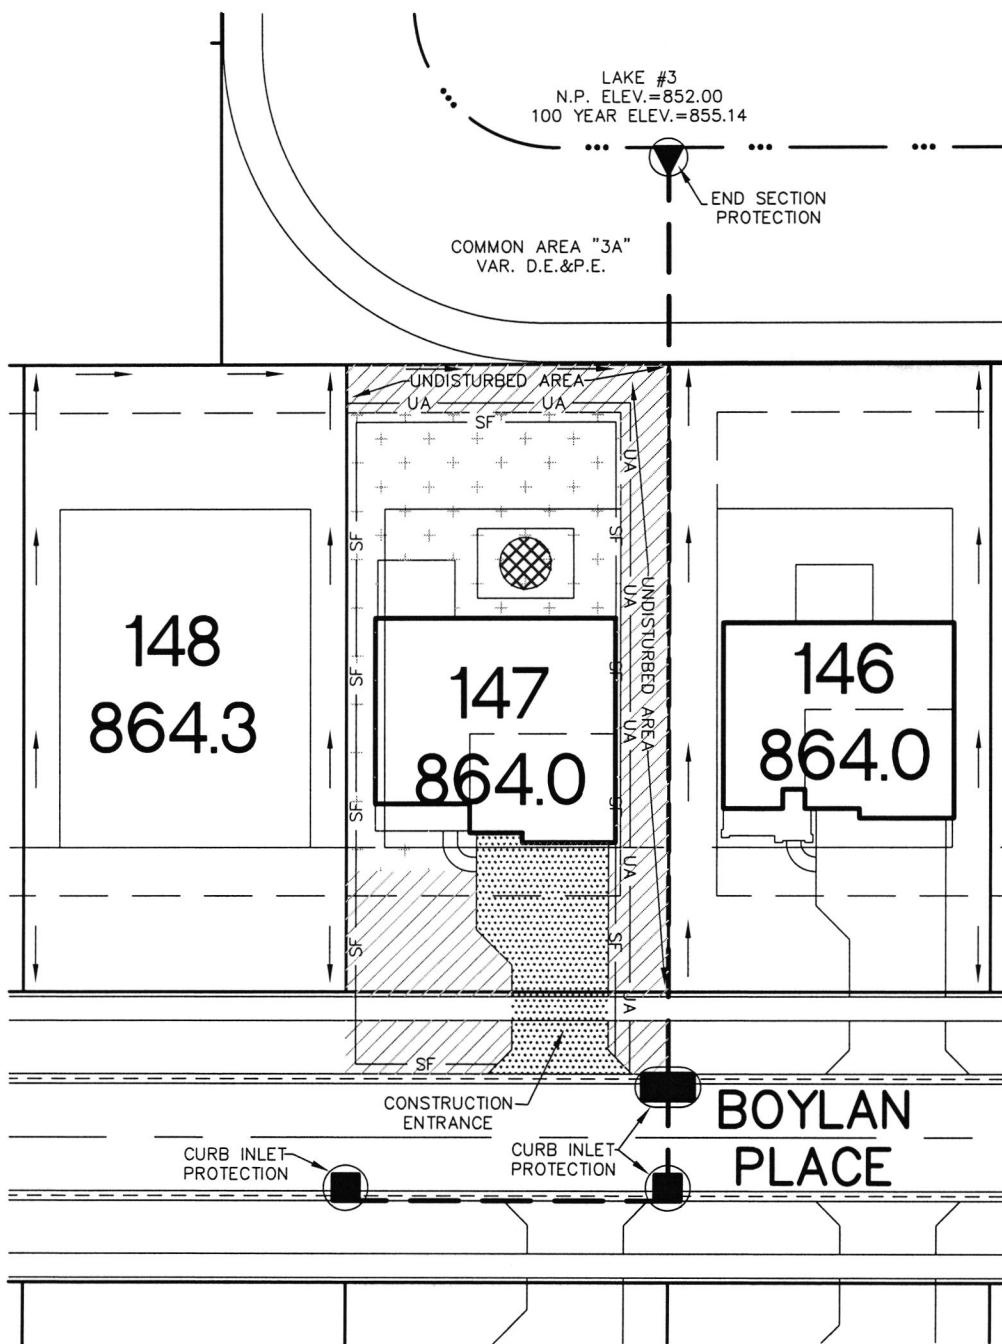

LEGEND:

- SF — SILT FENCE
- UA — UNDISTURBED AREA
- + + + + + DENOTES TEMPORARY SEEDING & MULCHING
- /// DENOTES PERMANENT SEEDING & MULCHING AREAS
- /// DENOTES SEEDING W/FIBER BLANKET
- STONE CONSTRUCTION ENTRANCE
- SOIL STOCKPILE

THIS LOT LIES IN ZONE: X  
COMMUNITY PANEL: # 18095C0305 E  
DATE: JUNE 6, 2014

**Lennar Homes of Indiana, Inc.**  
11555 N. Meridian Street, Suite 400  
Carmel, IN 46032

**LOT 147**  
**SPRINGBROOK**  
**SECTION 3**

INST. #2020R017818

ZONING: R3

5' MINIMUM SIDE YARD  
30' MINIMUM FRONT YARD  
15' MINIMUM REAR YARD



I HEREBY CERTIFY THAT THE DRAINAGE WAYS, PAD ELEVATIONS, AND EROSION AND SEDIMENT CONTROL MEASURES ARE CONSISTENT WITH THE OVERALL DEVELOPMENT PLANS.

*David J. Stoeppelwerth*


NOTE: THIS DRAWING IS NOT INTENDED TO BE REPRESENTED AS A RETRACEMENT OR ORIGINAL BOUNDARY SURVEY, A ROUTE SURVEY OR A SURVEYOR LOCATION REPORT.

02/15/21 NSH





147 Spring Brook 8913 Boylan Baldwin Ex 6-4-21

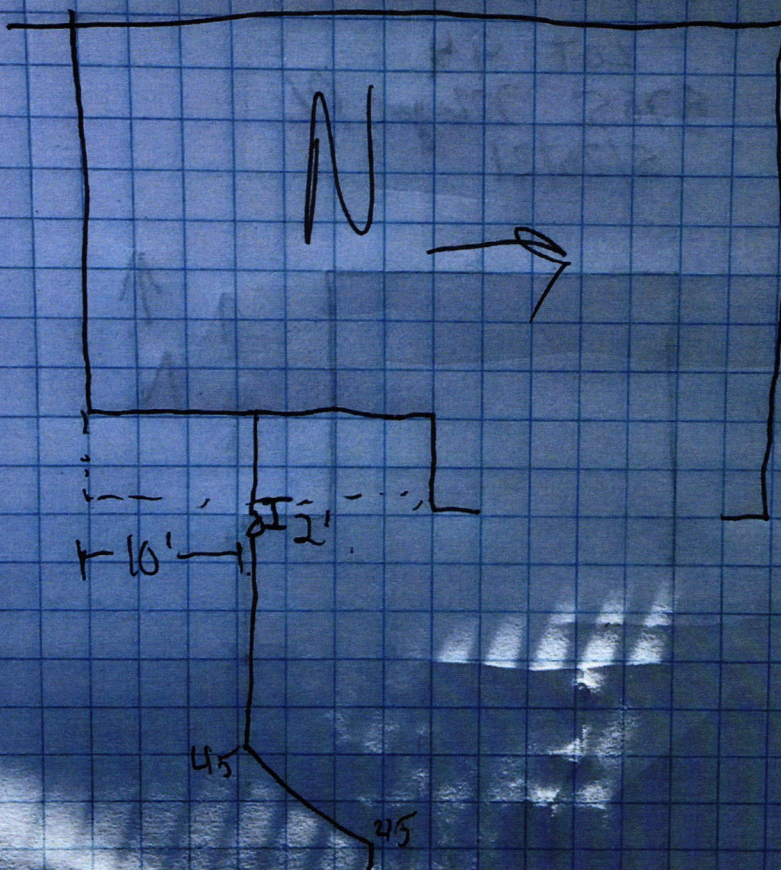











**Lennar Homes of Indiana Inc**  
11555 N Meridian St Ste 400

JPMorgan Chase Bank N.A.  
Chicago, IL

**01573391**

Carmel, IN 46032

*Void if over 180 days*

70-2322  
719

**PAY**


DATE	AMOUNT
02/22/21	\$*****760.00

SEVEN HUNDRED SIXTY AND 00/100 \*\*\*\*\*

**DOLLARS**

TO  
THE  
ORDER  
OF

Fall Creek Regional Waste District  
PO Box 59  
Pendleton IN 46064

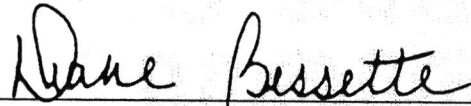  
Authorized Signatory

**COPY**