







03/23/21 NSH

 **Indiana 811**


Know what's below.  
Call before you dig.



Springbrook Lot #123  
Baldwin Exw.

7/30/21

N ←

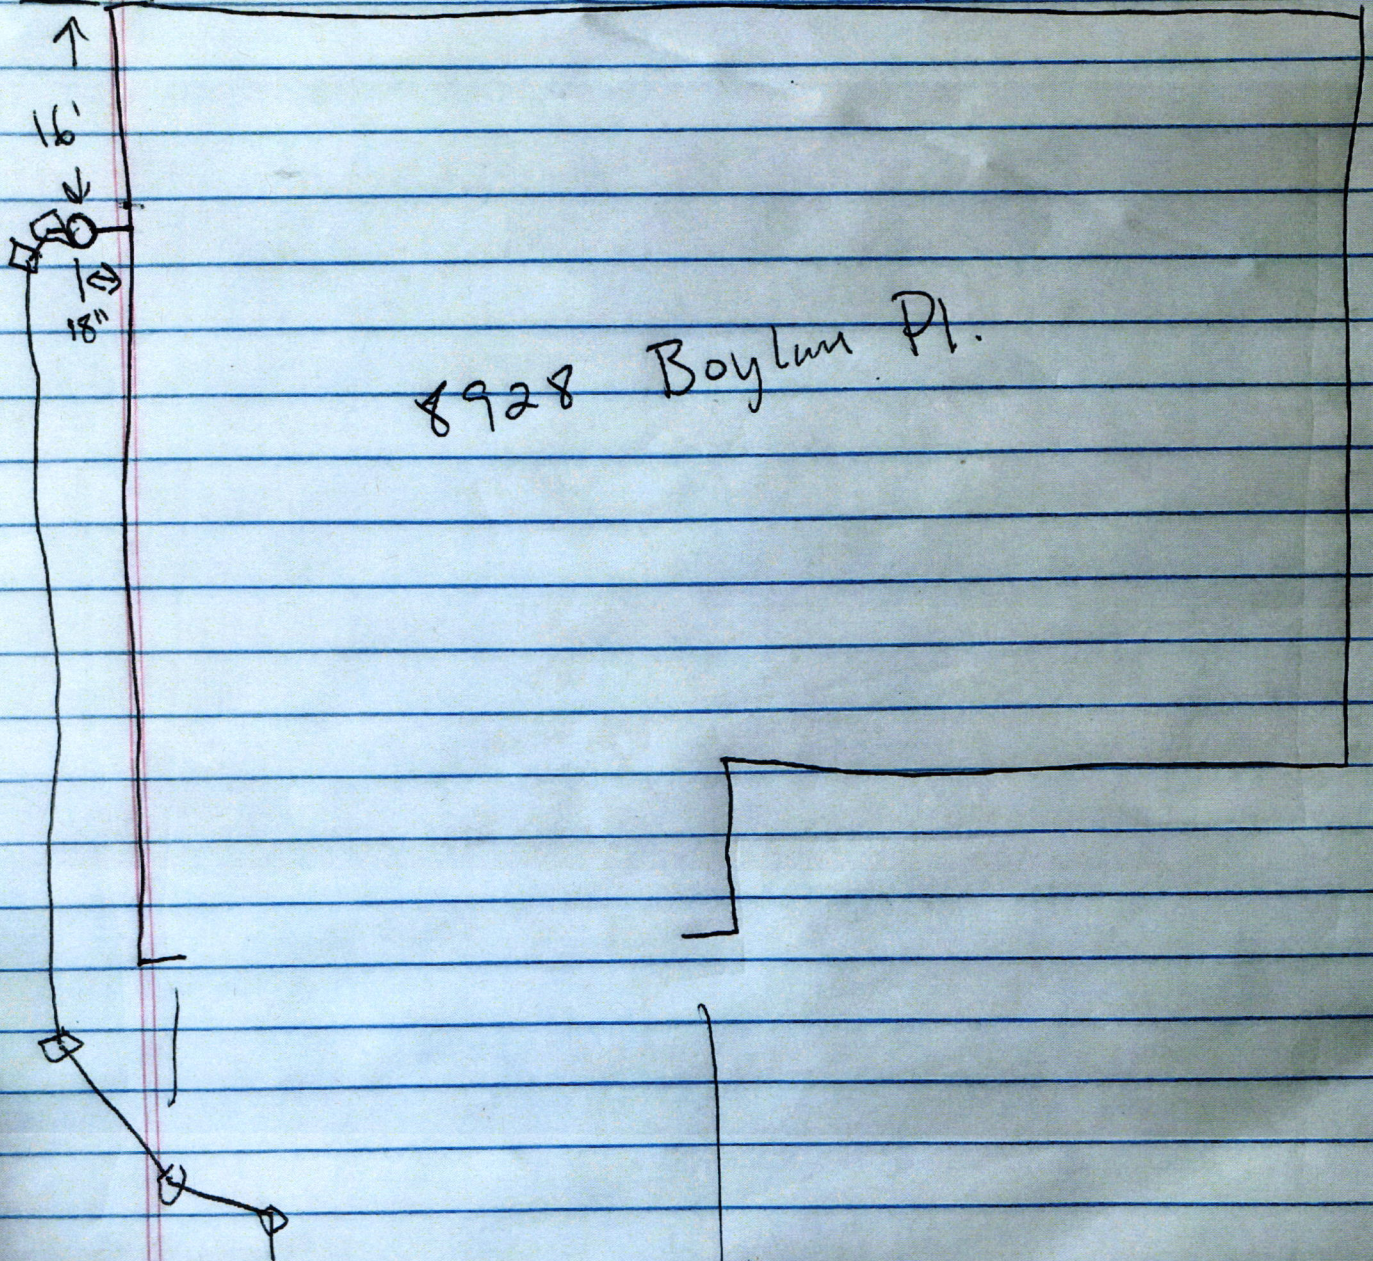















**Lennar Homes of Indiana Inc**  
11555 N Meridian St Ste 400

JPMorgan Chase Bank N.A.  
Chicago, IL

**01589711**

Carmel, IN 46032

*Void if over 180 days*

70-2322  
719


**PAY**

DATE	AMOUNT
03/22/21	\$*****760.00

SEVEN HUNDRED SIXTY AND 00/100 \*\*\*\*\*

**DOLLARS**

TO  
THE  
ORDER  
OF  
Fall Creek Regional Waste District  
PO Box 59  
Pendleton IN 46064

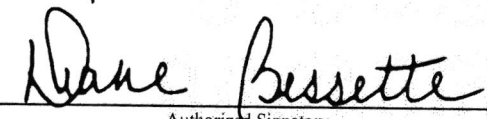  
Authorized Signatory

Rec'd 04/6/18