


4690

AGREEMENT FOR SANITARY SEWER SERVICE

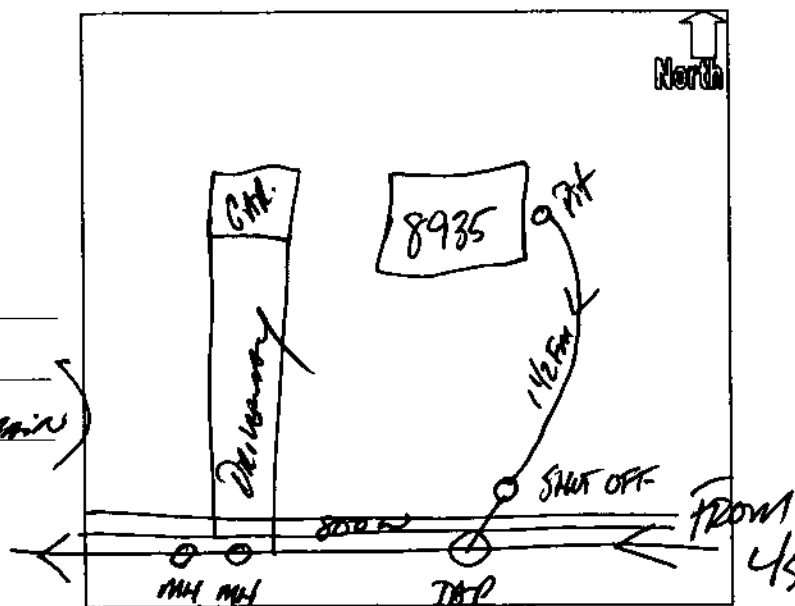

KENT D. JONES
8935 S CR 800 W
PENDLETON, IN 46064

20-7043/2740
170007962

170

DATE 10/23/02

PAY TO THE
ORDER OF

Fau Creek Regional Waste \$ 1499.80

One thousand four hundred ninety nine and 80/100 DOLLARS



FIRST INDIANA[®] BANK
INDIANAPOLIS, INDIANA 46204

04-98

Kent D Jones

MEMO

⑆ 274070439⑆

SAFETY PAPER

DATE

REFERENCE / INVOICE NO.

APV NUMBER

INVOICE AMOUNT

BALANCE

8/23/04

refund of connection fees & grinder
per grant agreement

\$2441.30

Tap fee	\$475.00
capacity fee	\$941.50
grinder	\$976.00
Tax	\$48.80

I HAVE RECEIVED AND ACCEPTED

THIS RECEIPT IS VALID FOR THE
PURPOSE OF THE GRANT

FORM APPROVED BY STATE BOARD OF AGENCIES FOR FALL CREEK REGIONAL WASTE DISTRICT 1988

FALL CREEK REGIONAL WASTE DISTRICT

PENDLETON, INDIANA 46064

TREASURER

019419

RECEIVED FROM

DATE

CHECK NUMBER

FUND

PAY EXACTLY

8/23/04

19419

100


\$2,441.30

Two Thousand Four Hundred Forty One Dollars and 30/100*

Kent Jones

MADISON COUNTY INDIANA
PENDLETON INDIANA

TREASURER

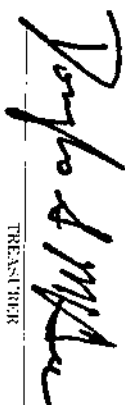

019419 00749055391



FALL CREEK REGIONAL WASTE DISTRICT

P.O. Box 59 • 9378 S. 650 West • Pendleton, Indiana 46064-0059 • (765) 778-7544

August 23, 2004

Mr. Kent Jones
8935 S 800 W
Pendleton, IN 46064

Dear Mr. & Mrs. Jones:

Recently the Fall Creek Regional Waste District (FCRWD) was pleased to announce that a Community Focus Fund Grant has been awarded to the Town of Ingalls with FCRWD as a sub recipient by the Indiana Department of Commerce to fund construction of a wastewater collection system for the areas of Green Township known as County Roads 650 West, 750 West, 760 West, 900 South, 920 South, 800 West, 800 South, 875 South, Fall Creek Drive (between CR 650 W and CR 750 W), and Carefree Community Homes.

As Fall Creek Regional Waste District promised and as a result of the grant, residents in these areas will not be charged any connection fees and will be provided a residential wastewater grinder unit at no cost when they connect their homes to the sanitary system.

Enclosed please find a check in the amount of \$2,441.30 as reimbursement of your connection fees and the cost of your wastewater grinder unit.

Thank you for your support of our successful grant efforts.

Sincerely,

Teresa K. Hutton
Office Manager