

FALL CREEK REGIONAL WASTE DISTRICT

No 5527

9378 S 650 WEST, P.O. BOX 59, PENDLETON, IN 46064

765-778-7544

AGREEMENT FOR SANITARY SEWER SERVICE

This Agreement made and entered into this 13th day of April, 2005, between FALL CREEK REGIONAL WASTE DISTRICT ("District") and Robert Taylor ("Applicant") regarding the provision of sanitary sewer service, and the assignment of capacity in, and connection to, the District's facilities for the premises located at Fiddlers Green lot 119

NOW THEREFORE, the parties, in consideration of the mutual promises set out in this Agreement, the receipt and sufficiency of which is hereby acknowledged, agree as follows:

1. The Applicant agrees that all v the District's construction standards. Distri connection is made to the sewer mains. Any to be removed and replaced at the Applicant

inform to all District ordinances and k and materials before backfilling and final use all lines and appurtenances in violation

2. The District shall have the right inspect, repair, or replace any equipment us service.

misses at all reasonable times to service or which has an impact on said

3. The Applicant shall be responsible for all monthly user rates, capacity charges, and tap fees. The failure to pay any rate charge or fee may result in a lien against the property and/or the termination of service to the property, the cost of which will be borne by Applicant, including, but not limited to, all attorney's fees and collection costs.

4. The District shall not be responsible for any damages as a result of any failure to supply service unless said damages are due to default, neglect or culpability on the part of the District.

5. If there is an available sanitary sewer within three hundred (300) feet of the property line, the property owner shall be required to connect to the District's sanitary sewer system.

6. The Applicant and District agree that the provision of sanitary sewer service touches and concerns the property and the terms of this Agreement bind the District and Applicant and their heirs, executors, administrators, personal representatives, successors, agents, attorneys, assigns, designees, and transferees.

The parties hereto have read and fully understand the above provisions and agree to comply with said provisions.

FALL CREEK REGIONAL WASTE DISTRICT
Signature Deborah L. Wilson

APPLICANT
Signature Cindy L. Costen

STATE OF INDIANA)
) SS:
COUNTY OF MADISON)

SUBSCRIBED and sworn to before me this 13th day of April, 2005.

My Commission Expires:

2-20-2008

Signature Deborah L. Wilson

Printed Deborah L. Wilson

Notary Public

Resident of Madison County

INSPECTOR T DATE INSPECTED 7/29/05 APPROVED _____ REJECTED _____

REASON FOR REJECTION _____

DATE REINSPECTED _____ APPROVED _____ REJECTED _____

NOTES:

SIZE PIPE 6" TYPE PIPES SDR 35

BASEMENT YES _____ NO ✓

SUMP PUMP YES _____ NO ✓

DOWNSPOUT TO GROUND YES ✓ NO _____


SEPTIC TANK PUMPED & FILLED YES _____ NO _____

CONTRACTOR Taylor (Don Brown)

SPECIAL CONDITIONS _____

EXISTING HOME _____

NEW CONSTRUCTION ✓

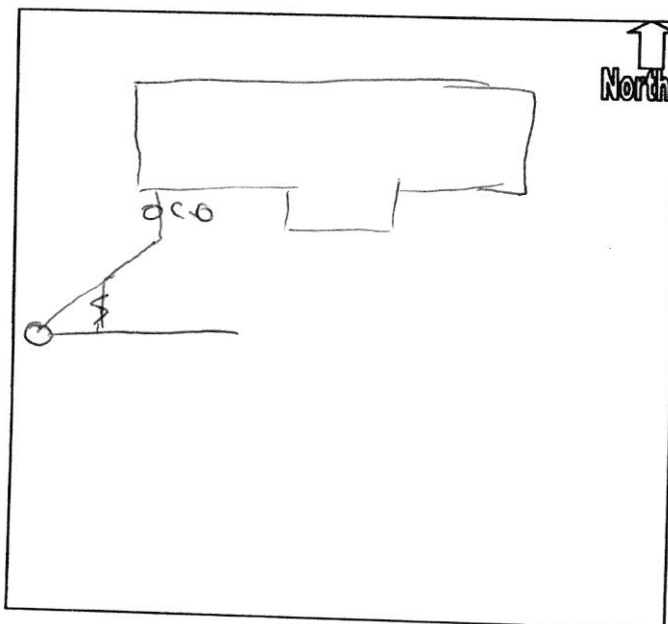

№ 5527

765-778-7544

This Agreement made and entered into this 13th day of April, 2005, between FALL CREEK REGIONAL WASTE DISTRICT ("District") and Robert Taylor ("Applicant") regarding the provision of sanitary sewer service, and the assignment of capacity in, and connection to, the District's facilities for the premises located at Fiddlers Green 104119.

1. The Applicant agrees that all v the District's construction standards. Distri connection is made to the sewer mains. Any to be removed and replaced at the Applicant

inform to all District ordinances and
work and materials before backfilling and final
use all lines and appurtenances in violation

permits at all reasonable times to
service or which has an impact on said

4. The District shall not be responsible for any damages as a result of any failure to supply service unless said damages are due to default, neglect or culpability on the part of the District.

6. The Applicant and District agree that the provision of sanitary sewer service touches and concerns the property and the terms of this Agreement bind the District and Applicant and their heirs, executors, administrators, personal representatives, successors, agents, attorneys, assigns, designees, and transferees.

FALL CREEK REGIONAL WASTE DISTRICT
Robert Wilson
 Signature

APPLICANT Cindy L. Costerson
Signature

SUBSCRIBED and sworn to before me this 13th day of April, 2005

My Commission Expires:

Signature Robert N. Wilson

Printed Deborah L. Wilson

Notary Public
Resident of Madison County

INSPECTOR _____ DATE INSPECTED _____ APPROVED _____ REJECTED _____

REASON FOR REJECTION _____

DATE REINSPECTED _____ APPROVED _____ REJECTED _____

NOTES:

SIZE PIPE _____ TYPE PIPE _____

BASEMENT YES NO

SUMP PUMP YES NO

DOWNSPOUT TO GROUND YES NO


SEPTIC TANK PUMPED & FILLED YES NO


CONTRACTOR _____

SPECIAL CONDITIONS

EXISTING HOME

NEW CONSTRUCTION

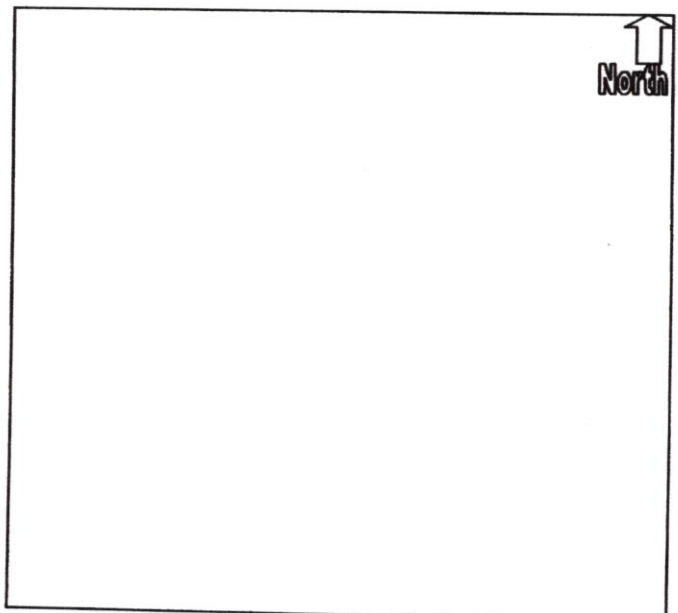

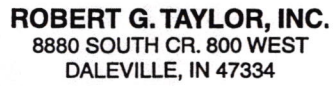

2698

AMOUNT
*****\$2,635.00

Two Thousand Six Hundred Thirty-Five and 00/100 Dollars
Fall Creek Regional Waste Dist
P.O. Box 59
Pendleton, IN 46064

Cindy L. Coetzer MP
AUTHORIZED SIGNATURE

11002698 10749006571 193 278 0