



FALL CREEK REGIONAL WASTE DISTRICT

Box 44, Pendleton, Indiana 46064

9002 Surrey
22-03010.00

2-0003010.00

Nº 001659

APPLICATION FOR SEWER PERMIT

Permit No. _____ Date 11-23-88
Permit Void 90 days from Date of Issuance
Owner Name Jeffery Dunlap
Property Address 9000 SURREY LANE
Lot # 64 P.O. Box _____
Town _____, IN Zip Code _____
Phone _____ Water Meter _____"
\$ 500.00 Tap on Fee Paid
\$ 25 Inspection fee paid

Application is hereby made for connection to the Fall Creek Regional Waste District Sewer System for the above listed property - Permit Type: Residential _____, Commercial _____, Industrial _____, or Governmental/Institutional _____. User Information _____.

All workmanship and materials shall conform to the standards of the District Ordinance as described in Ordinance 84-2 and 84-3 as amended. Acceptance and approval must be made by the District inspector or his duly authorized representative before backfilling and final connection is made to the main sewer lines. Any violation of applicable regulations will cause all lines and appurtenances in violation to be removed and replaced at the owners expense.

The Fall Creek Regional Waste District is responsible for the inspection, approval of materials, and installation techniques only. All costs for materials and installation and any liabilities resulting from same is the sole responsibility of the property owner.

I have read and fully understand the above provisions and agree to comply by said provisions.

Lindy S. Slack

APPLICANT(S) SIGNATURE

INSPECTOR B

Date inspected 11-23-88 Approved - Rejected _____

Reason for rejection _____

Date reinspected _____ Approved _____ Rejected _____

Notes:

Size Pipe 6 "

Type Pipe PVC

Basement Yes _____ No X


Sump Pump Yes _____ No X

Downspout to Ground Yes X No _____

Septic Tank Pumped & filled Yes _____ No X

Contractor Lindy Slack

Special Conditions New Home

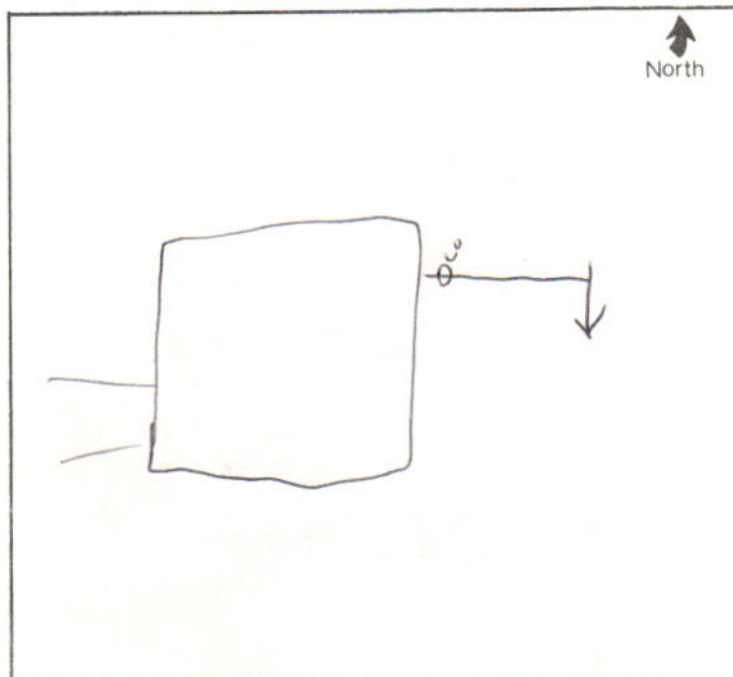

ROBERT G. TAYLOR
DOROTHY M. TAYLOR
8880 S. 800 WEST
DALEVILLE, INDIANA 47334

DATE	INVOICE	AMOUNT

71-830
749

4425

PAY REGISTERED 350 DOLS 00 CTS DOLLARS

DATE	TO THE ORDER OF	CHECK NO.	DESCRIPTION	CHECK AMOUNT
8-5-94	FALL CREEK Regional Waste Dist.	4425	350.00	350.00
			GROSS	DISCOUNT

P.O. Box 59

Pendleton, IN 46064

FIRST UNITED BANK
MIDDLETOWN, INDIANA

ROBERT G. OR DOROTHY M. TAYLOR

Sara Elizabeth Fisher

Lot 63 Fiddle's Green
CN Sec. 3

TAP FEE for J. Dunlap Property
⑈004425⑈ ⑆074908303⑆

PRESCRIBED BY STATE BOARD OF ACCOUNTS BOYCE FORMS SYSTEMS, MUNCIE, IN.

GENERAL FORM NO. 351

RECEIPT

FALL CREEK REGIONAL WASTE DISTRICT
P.O. BOX 59, CO. RD. 650 WEST

№ 4549

Gen FUND

PENDLETON, IND. 46064, 8/8 1994

RECEIVED FROM Robert G. Taylor \$ 350.00

THE SUM OF Three hundred fifty & 00/100 DOLLARS

ON ACCOUNT OF tap fee for Jff Dunlap
lot 63- Fiddle's Green

PAID BY: CASH ☐ CHECK ☒ M.O. ☐ 4425

Debbie Wilson

AUTHORIZED SIGNATURE