

FALL CREEK REGIONAL WASTE DISTRICT

No 6085

9378 S 650 WEST, P.O. BOX 59, PENDLETON, IN 46064

765-778-7544

AGREEMENT FOR SANITARY SEWER SERVICE

This Agreement made and entered into this 25 day of August, 2006, between FALL CREEK REGIONAL WASTE DISTRICT ("District") and Hallmark Homes ("Applicant") regarding the provision of sanitary sewer service, and the assignment of capacity in, and connection to, the District's facilities for the premises located at 9030 S 800 W Brian Doty

NOW THEREFORE, the parties, in consideration of the mutual promises set out in this Agreement, the receipt and sufficiency of which is hereby acknowledged, agree as follows:

1. The Applicant agrees that all workmanship and materials shall conform to all District ordinances and the District's construction standards. District must accept and approve all work and materials before backfilling and final connection is made to the sewer mains. Any violation of this provision will cause all lines and appurtenances in violation to be removed and replaced at the Applicant's expense.
2. The District shall have the right to enter upon the Applicant's premises at all reasonable times to inspect, repair, or replace any equipment used in connection with the District's service or which has an impact on said service.
3. The Applicant shall be responsible for all monthly user rates, capacity charges, and tap fees. The failure to pay any rate charge or fee may result in a lien against the property and/or the termination of service to the property, the cost of which will be borne by Applicant, including, but not limited to, all attorney's fees and collection costs.
4. The District shall not be responsible for any damages as a result of any failure to supply service unless said damages are due to default, neglect or culpability on the part of the District.
5. If there is an available sanitary sewer within three hundred (300) feet of the property line, the property owner shall be required to connect to the District's sanitary sewer system.
6. The Applicant and District agree that the provision of sanitary sewer service touches and concerns the property and the terms of this Agreement bind the District and Applicant and their heirs, executors, administrators, personal representatives, successors, agents, attorneys, assigns, designees, and transferees.

The parties hereto have read and fully understand the above provisions and agree to comply with said provisions.

FALL CREEK REGIONAL WASTE DISTRICT
Chbecca Hunter
Signature

APPLICANT
Hallmark Homes
Signature Willy Wilson

STATE OF INDIANA)
) SS:
COUNTY OF MADISON)

SUBSCRIBED and sworn to before me this 25th day of August, 2006.

My Commission Expires: 2-20-2008

Signature Deborah L. Wilson
Printed Deborah L. Wilson

Notary Public
Resident of Madison County

INSPECTOR JT DATE INSPECTED 3-26-07 APPROVED _____ REJECTED _____

REASON FOR REJECTION _____

DATE REINSPECTED _____ APPROVED _____ REJECTED _____

NOTES:

SIZE PIPE 1 1/2 TYPE PIPE well pipe

BASEMENT YES _____ NO X

SUMP PUMP YES _____ NO X

DOWNSPOUT TO GROUND YES X NO _____


SEPTIC TANK PUMPED & FILLED YES _____ NO _____

CONTRACTOR Home owner

SPECIAL CONDITIONS _____

EXISTING HOME _____

NEW CONSTRUCTION X

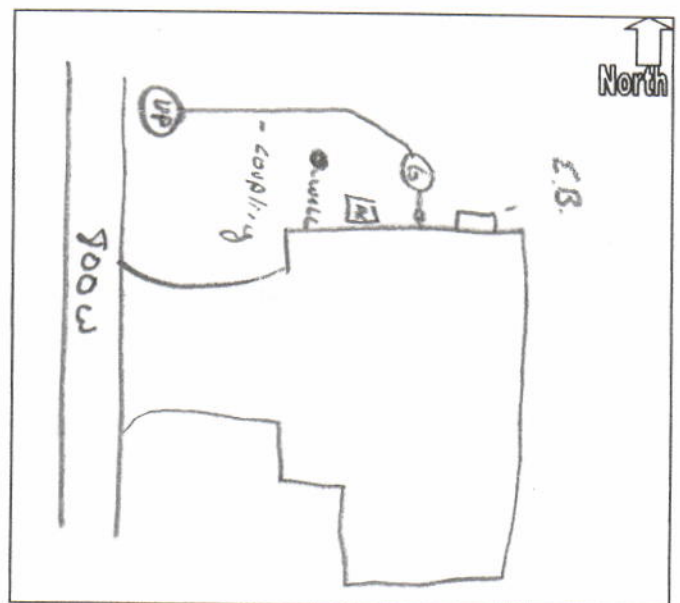

HALL MARK HOMES, INC.

433 E. 53RD STREET
ANDERSON, IN 46013
(765) 644-6566

STAR FINANCIAL BANK
INDIANAPOLIS, IN 46255
71-1677749

89228

8/25/2006

PAY TO THE
ORDER OF

Fall Creek Regional Waste

\$**2,635.00

Two Thousand Six Hundred Thirty-Five and 00/100*****

DOLLARS

Fall Creek Regional Waste



MEMO

⑈089228⑈ ⑆074901672⑆

HALLMARK HOMES, INC.
1355 3RD STREET
NEEDSVILLE, OH 44131
(216) 514-5566

3/9/2007

PAID TO THE ORDER OF Fall Creek Regional Waste

\$ **4,013.00

Four Thousand Thirteen and 00/100*****

DOLLARS

Fall Creek Regional Waste



MEMO

⑈091708⑈ ⑆074901672⑆

HALLMARK HOMES, INC.

91708

Fall Creek Regional Waste

3/9/2007

COST OF SALES:SITE IMPROVEMENTS:8400 Doty-grinder pump
COST OF SALES:SITE IMPROVEMENTS:8020 Kail-sewer tap

1,378.00
2,635.00

Hallmark Homes Inc.- Star

4,013.00