

27-00045.00

FALL CREEK REGIONAL WASTE DISTRICT

9378 S 650 WEST, P.O. BOX 59, PENDLETON, IN 46064

765-778-7544

4765

AGREEMENT FOR SANITARY SEWER SERVICE

This Agreement made and entered into this 11th day of February, 2003, between FALL CREEK REGIONAL WASTE DISTRICT ("District") and Cullen Lynch ("Applicant") regarding the provision of sanitary sewer service, and the assignment of capacity in, and connection to, the District's facilities for the premises located at 9015 S 750 W, Pendleton

NOW THEREFORE, the parties, in consideration of the mutual promises set out in this Agreement, the receipt and sufficiency of which is hereby acknowledged, agree as follows:

- 1. The Applicant agrees that all workmanship and materials shall conform to all District ordinances and the District's construction standards. District must accept and approve all work and materials before backfilling and final connection is made to the sewer mains. Any violation of this provision will cause all lines and appurtenances in violation to be removed and replaced at the Applicant's expense.
2. The District shall have the right to enter upon the Applicant's premises at all reasonable times to inspect, repair, or replace any equipment used in connection with the District's service or which has an impact on said service.
3. The Applicant shall be responsible for all monthly user rates, capacity charges, and tap fees. The failure to pay any rate charge or fee may result in a lien against the property and/or the termination of service to the property, the cost of which will be borne by Applicant, including, but not limited to, all attorney's fees and collection costs.
4. The District shall not be responsible for any damages as a result of any failure to supply service unless said damages are due to default, neglect or culpability on the part of the District.
5. If there is an available sanitary sewer within three hundred (300) feet of the property line, the property owner shall be required to connect to the District's sanitary sewer system.
6. The Applicant and District agree that the provision of sanitary sewer service touches and concerns the property and the terms of this Agreement bind the District and Applicant and their heirs, executors, administrators, personal representatives, successors, agents, attorneys, assigns, designees, and transferees.

The parties hereto have read and fully understand the above provisions and agree to comply with said provisions.

FALL CREEK REGIONAL WASTE DISTRICT
Signature [Signature]

APPLICANT
Signature [Signature]

STATE OF INDIANA)
) SS:
COUNTY OF MADISON)

SUBSCRIBED and sworn to before me this 11th day of February, 2003.


My Commission Expires: 2-20-2008

Signature [Signature]
Printed Deborah L. Wilson
Notary Public
Resident of Madison County

INSPECTOR Tim DATE INSPECTED 3-17-03 APPROVED [check] REJECTED

REASON FOR REJECTION
DATE REINSPECTED APPROVED REJECTED

- NOTES:
SIZE PIPE 4" 1 1/2" TYPE PIPE SCRS-160
BASEMENT YES / NO
SUMP PUMP YES / NO
DOWNSPOUT TO GROUND YES / NO
SEPTIC TANK PUMPED & FILLED YES / NO
CONTRACTOR SELF
SPECIAL CONDITIONS will move washer
EXISTING HOME Drain Later
NEW CONSTRUCTION

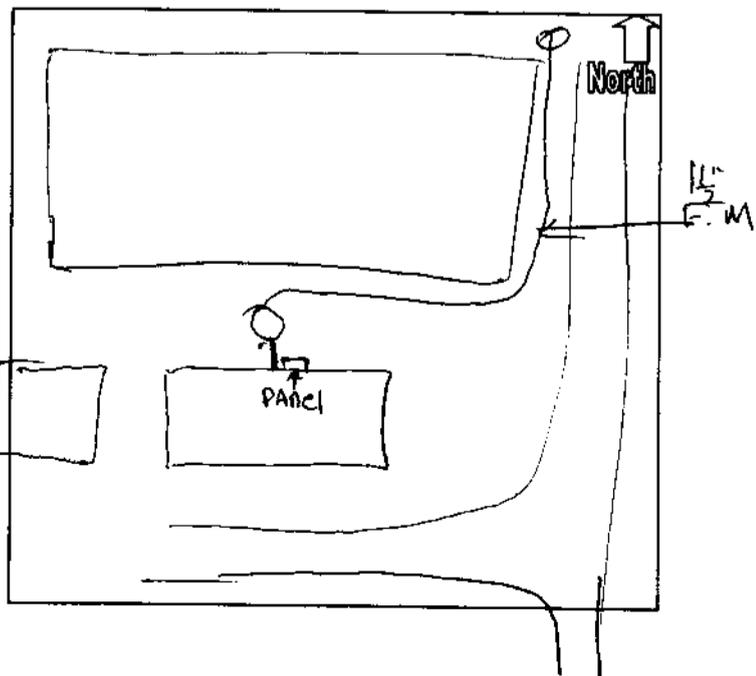

SEALED-RITE, INC.
9075 S. CO. RD. 750 WEST
PENDLETON, IN 46064

FED FDI#
35-2058634

#778-1344

DATE	INVOICE	AMOUNT

20-104740

6242

PAY Thirty six Sixty nine 56/100 DOLLARS

CHECK
AMOUNT

DATE	TO THE ORDER OF	DESCRIPTION	CHECK NO.
2-11-03	FCRWD	Sewer	6242

\$ 3669.56

 KeyBank National Association
INDIANAPOLIS, INDIANA

[Handwritten Signature]

⑈006242⑈ ⑈074001048⑈

SECURITY FEATURES: MICRO PRINT BORDERS - COLORED BRICK PATTERN - WATERMARK & CARBON STRIP ON REVERSE SIDE - MISSING FEATURE INDICATES A COPY



FALL CREEK REGIONAL WASTE DISTRICT

P.O. Box 59 • 9378 S. 650 West • Pendleton, Indiana 46064-0059 • (765) 778-7544

August 23, 2004

Mr. Cullin Lynch
9075 S 750 W
Pendleton, IN 46064

Dear Mr. Lynch:

Recently the Fall Creek Regional Waste District (FCRWD) was pleased to announce that a Community Focus Fund Grant has been awarded to the Town of Ingalls with FCRWD as a sub recipient by the Indiana Department of Commerce to fund construction of a wastewater collection system for the areas of Green Township known as County Roads 650 West, 750 West, 760 West, 900 South, 920 South, 800 West, 800 South, 875 South, Fall Creek Drive (between CR 650 W and CR 750 W), and Carefree Community Homes.

As Fall Creek Regional Waste District promised and as a result of the grant, residents in these areas will not be charged any connection fees and will be provided a residential wastewater grinder unit at no cost when they connect their homes to the sanitary system.

Enclosed please find a check in the amount of \$3,669.56 as reimbursement of your connection fees and the cost of your wastewater grinder unit.

Thank you for your support of our successful grant efforts.

Sincerely,

Teresa K. Hutton
Office Manager

DATE	REFERENCE / INVOICE NO.	APV NUMBER	INVOICE AMOUNT	BALANCE
------	-------------------------	------------	----------------	---------

8/23/04 refund of connection fees & grinder \$3,669.56
 per Grant Agreement

Tap Fee \$475.00
 Capacity Fee \$2160.00
 Grinder \$976.00
 Tax \$58.56

DUPLICATE AND RETURN FOR VENDOR RECORDS

FALL CREEK REGIONAL WASTE DISTRICT		019410	
PENDLETON, INDIANA 46064		71 535739	
FORM APPROVED BY STATE BOARD OF ACCOUNTS FOR FALL CREEK REGIONAL WASTE DISTRICT 1988	DATE	CHECK NUMBER	FUND
	8/23/04	19410	100
*Three Thousand Six Hundred Sixty Nine Dollars and 56/100**		*\$3,669.56*	
Cullin Lynch		TREASURER	
MADISON COMMUNITY BANK PENDLETON, INDIANA			

⑆019410⑆ ⑆074905539⑆