

FALL CREEK REGIONAL WASTE DISTRICT

9378 S 650 WEST, P.O. BOX 59, PENDLETON, IN 46064

765-778-7544

AGREEMENT FOR SANITARY SEWER SERVICE

This Agreement made and entered into this 9th day of March, 2001, between FALL CREEK REGIONAL WASTE DISTRICT ("District") and Rusty Bodenhorn ("Applicant") regarding the provision of sanitary sewer service, and the assignment of capacity in, and connection to, the District's facilities for the premises located at 907 Red Oak Lane.

NOW THEREFORE, the parties, in consideration of the mutual promises set out in this Agreement, the receipt and sufficiency of which is hereby acknowledged, agree as follows:

1. The Applicant agrees that all workmanship and materials shall conform to all District ordinances and the District's construction standards. District must accept and approve all work and materials before backfilling and final connection is made to the sewer mains. Any violation of this provision will cause all lines and appurtenances in violation to be removed and replaced at the Applicant's expense.

2. The Applicant agrees to enter upon the Applicant's premises at all reasonable times to inspect, maintain, and repair the sanitary sewer system in connection with the District's service or which has an impact on said service.

3. The Applicant is responsible for all monthly user rates, capacity charges, and tap fees. The failure to pay any such charges may result in a lien against the property and/or the termination of service to the property. The Applicant, including, but not limited to, all attorney's fees and collection costs.

4. The District is not responsible for any damages as a result of any failure to supply service unless said damages are due to default, neglect or culpability on the part of the District.

5. If there is an available sanitary sewer within three hundred (300) feet of the property line, the property owner shall be required to connect to the District's sanitary sewer system.

6. The Applicant and District agree that the provision of sanitary sewer service touches and concerns the property and the terms of this Agreement bind the District and Applicant and their heirs, executors, administrators, personal representatives, successors, agents, attorneys, assigns, designees, and transferees.

The parties hereto have read and fully understand the above provisions and agree to comply with said provisions.

FALL CREEK REGIONAL WASTE DISTRICT

Signature

APPLICANT

Signature

STATE OF INDIANA)

) SS:

COUNTY OF MADISON)

SUBSCRIBED and sworn to before me this 9th day of March, 2001.

My Commission Expires:

4-19-2008

Signature

Printed

Notary Public

Resident of Madison County

INSPECTOR Tim DATE INSPECTED 8-1-01 APPROVED ✓ REJECTED _____

REASON FOR REJECTION _____

DATE REINSPECTED _____ APPROVED _____ REJECTED _____

NOTES:


SIZE PIPE 4" / 1 1/2 TYPE PIPE SDR35 / 1 1/2 cts

BASEMENT YES ✓ NO _____SUMP PUMP YES ✓ NO _____DOWNSPOUT TO GROUND YES ✓ NO _____SEPTIC TANK PUMPED & FILLED YES ✓ NO _____CONTRACTOR Royal Flush

SPECIAL CONDITIONS _____

EXISTING HOME ✓

NEW CONSTRUCTION _____

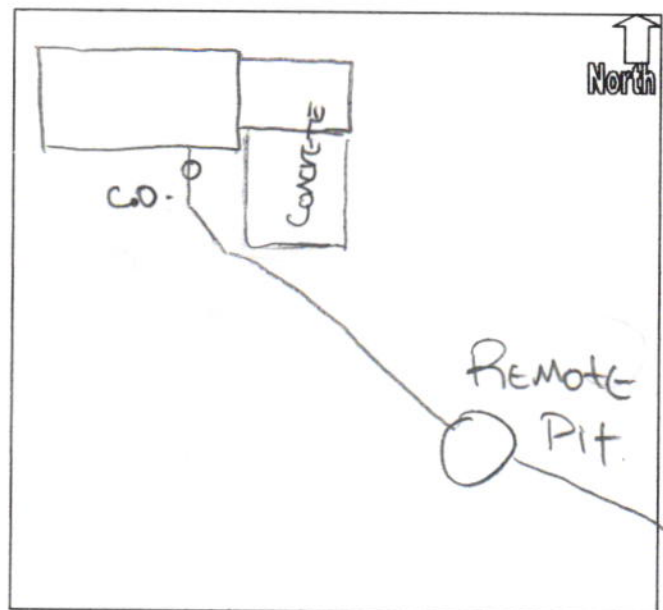

CURRENT INC. • TO RECORDER • 800-254-3244 • Please Celebrate the Life

Rusty A. or Susan E. Bodenhorn
907 Red Oak Lane Ph. 763-778-3207
Pendleton, IN 46064

20-7043/2740

5729

Date 03/09/01

Pay to the Order of Fall Creek Regional Waste District

\$ 3,580.⁸⁰

Three thousand five hundred eighty dollars and ⁸⁰/₁₀₀ Dollars

FIRST INDIANA BANK
INDIANAPOLIS, INDIANA 46204

Follow Your Heart

for Permit & Grinder Pump

Rusty Bodenhorn

⑆ 274070439⑆

5729

©Weedn Family Trust