

26-06053.00

FALL CREEK REGIONAL WASTE DISTRICT

No 5949

9378 S 650 WEST, P.O. BOX 59, PENDLETON, IN 46064

765-778-7544

AGREEMENT FOR SANITARY SEWER SERVICE

This Agreement made and entered into this 3<sup>rd</sup> day of March, 2006, between FALL CREEK REGIONAL WASTE DISTRICT ("District") and Gravel Lawn Cemetery ("Applicant") regarding the provision of sanitary sewer service, and the assignment of capacity in, and connection to, the District's facilities for the premises located at 4088 W 1025 S. Fortville, IN 46040.

NOW THEREFORE, the parties, in consideration of the mutual promises set out in this Agreement, the receipt and sufficiency of which is hereby acknowledged, agree as follows:

1. The Applicant agrees that all workmanship and materials shall conform to all District ordinances and the District's construction standards. District must accept and approve all work and materials before backfilling and final connection is made to the sewer mains. Any violation of this provision will cause all lines and appurtenances in violation to be removed and replaced at the Applicant's expense.

2. The District shall have the right to enter upon the Applicant's premises at all reasonable times to inspect, repair, or replace any equipment used in connection with the District's service or which has an impact on said service.

3. The Applicant shall be responsible for all monthly user rates, capacity charges, and tap fees. The failure to pay any rate charge or fee may result in a lien against the property and/or the termination of service to the property, the cost of which will be borne by Applicant, including, but not limited to, all attorney's fees and collection costs.

4. The District shall not be responsible for any damages as a result of any failure to supply service unless said damages are due to default, neglect or culpability on the part of the District.

5. If there is an available sanitary sewer within three hundred (300) feet of the property line, the property owner shall be required to connect to the District's sanitary sewer system.

6. The Applicant and District agree that the provision of sanitary sewer service touches and concerns the property and the terms of this Agreement bind the District and Applicant and their heirs, executors, administrators, personal representatives, successors, agents, attorneys, assigns, designees, and transferees.

The parties hereto have read and fully understand the above provisions and agree to comply with said provisions.

FALL CREEK REGIONAL WASTE DISTRICT

Signature

APPLICANT

Signature

STATE OF INDIANA )

) SS:

COUNTY OF MADISON )

SUBSCRIBED and sworn to before me this 3<sup>rd</sup> day of March, 2006.

My Commission Expires:

2-20-2008

Signature

Printed

Notary Public

Resident of Madison County

INSPECTOR JT:DM DATE INSPECTED 8-10-06 APPROVED ✓ REJECTED \_\_\_\_\_

REASON FOR REJECTION \_\_\_\_\_

DATE REINSPECTED \_\_\_\_\_ APPROVED \_\_\_\_\_ REJECTED \_\_\_\_\_

NOTES:

SIZE PIPE 2" TYPE PIPE well 160

BASEMENT YES NO ✓

SUMP PUMP YES NO ✓

DOWNSPOUT TO GROUND YES ✓ NO \_\_\_\_\_


SEPTIC TANK PUMPED & FILLED YES NO

CONTRACTOR Maggie of Greenfield

SPECIAL CONDITIONS \_\_\_\_\_

EXISTING HOME \_\_\_\_\_

NEW CONSTRUCTION X

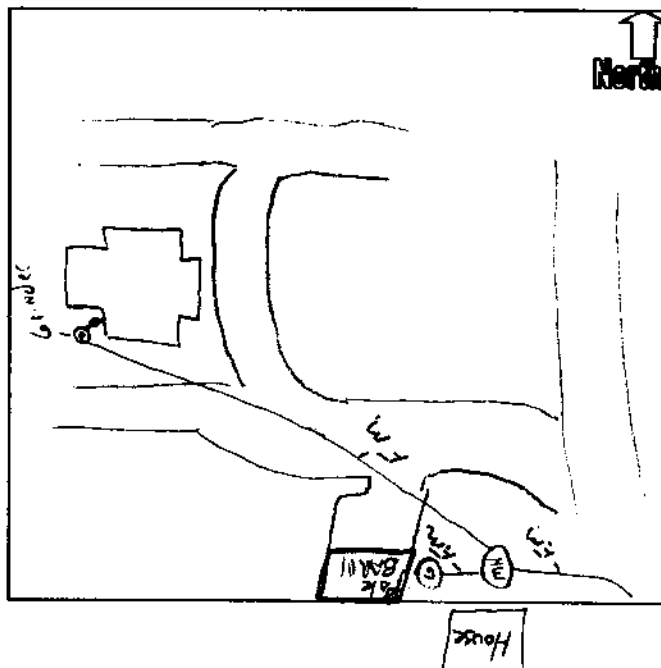

**GRAVEL LAWN CEMETERY CO.**  
317-485-5987  
P.O. BOX 35  
FORTVILLE, IN 46040

**GREENFIELD BANKING COMPANY**  
71-367749

**8634**

3/10/2006

**PAY TO THE ORDER OF** Fall Creek Regional Waste Dist.

**\$ \*\*2,160.00**

Two Thousand One Hundred Sixty and 00/100\*\*\*\*\*

**DOLLARS**

Fall Creek Reg. Waste Dist.  
P.O. Box 59  
Pendleton, IN 46064-0059

**MEMO**

Capacity Fee for Chapel permit

⑈008634⑈ ⑈071903670⑈

*Maria E. Neubauer*  
*Joe R. Good*  
AUTHORIZED SIGNATURE

**GRAVEL LAWN CEMETERY CO.**

Fall Creek Regional Waste Dist.

Capacity Fee for Chapel Permit

3/10/2006

**8634**

2,160.00

Greenfield Banking C Capacity Fee for Chapel permit

2,160.00

## RECEIPT

FALL CREEK REGIONAL WASTE DISTRICT

P.O. BOX 59, CO. RD. 650 WEST

No 8644

FUND

PENDLETON IN. 46064 11-7 2005

RECEIVED FROM CP Morgan \$950.00

THE SUM OF Nine hundred fifty 4<sup>00</sup>/<sub>100</sub> DOLLARS

ON ACCOUNT OF tap fees for Prairie Hollow

PAYMENT TYPE &amp; AMOUNT

CASH CHECK 39487 M.O.

E.F.T. C.C./B.C. 39497 OTHER

AUTHORIZED SIGNATURE

Prescribed by State Board of Accounts Boyce Forms Systems, Muncie, In.

GENERAL FORM NO. 352 (REV. 1997)

## RECEIPT

FALL CREEK REGIONAL WASTE DISTRICT

P.O. BOX 59, CO. RD. 650 WEST

No 8645

FUND

PENDLETON IN. 46064 11/7 2005

RECEIVED FROM Gravel Lawn Cemetery \$1378.00

THE SUM OF Thirteen hundred seventy eight 4<sup>00</sup>/<sub>100</sub> DOLLARS

ON ACCOUNT OF grinder unit for Chapel

PAYMENT TYPE &amp; AMOUNT

CASH CHECK 8530 M.O.

E.F.T. C.C./B.C. OTHER

AUTHORIZED SIGNATURE

Prescribed by State Board of Accounts Boyce Forms Systems, Muncie, In.

GENERAL FORM NO. 352 (REV. 1997)

## RECEIPT

FALL CREEK REGIONAL WASTE DISTRICT

P.O. BOX 59, CO. RD. 650 WEST

No 8646

FUND

PENDLETON IN. 46064 11/9 2005

RECEIVED FROM C.P. Morgan \$950.00

THE SUM OF Nine hundred fifty 4<sup>00</sup>/<sub>100</sub> DOLLARS

ON ACCOUNT OF tap fees for Sunnyside

PAYMENT TYPE &amp; AMOUNT

CASH CHECK 37522 M.O.

E.F.T. C.C./B.C. 37534 OTHER

AUTHORIZED SIGNATURE