

Agreement for Sanitary Sewer Service

This Agreement made and entered into this 9 day of January, 2012 between Fall Creek Regional Waste District ("District") and Gravel Lawn Center ("Applicant") regarding the provision of sanitary sewer service, and the assignment of capacity in and connection to, the District's facilities for the premises located at 9088 W 1025 S

Now therefore, the parties, in consideration of the mutual promises set out in this Agreement, the receipt and sufficiency of which is hereby acknowledged, agree as follows:

1. The Applicant agrees that all workmanship and materials shall conform to all District ordinances and the District's construction standards. District must accept and approve all work and materials before backfilling and final connection is made to the sewer mains. Any violation of this provision will cause all lines and appurtenances in violation to be removed and replaced at the Applicant's expense.
2. The District shall have the right to enter upon the Applicant's premises at all reasonable times to inspect, repair, or replace any equipment used in connection with the District's service or which has an impact on said service.
3. The Applicant shall be responsible for all monthly user rates, capacity charges, and tap fees. The failure to pay any rate charge or fee may result in a lien against the property and/or the termination of service to the property, the cost of which will be borne by Applicant, including, but not limited to, all attorney's fees and collection costs.
4. The District shall not be responsible for any damages as a result of any failure to supply service unless said damages are due to default, neglect or culpability on the part of the District.
5. If there is an available sanitary sewer within three hundred (300) feet of the property line, the property owner shall be required to connect to the District's sanitary sewer system.
6. The Applicant and District agree that the provision of sanitary sewer service touches and concerns the property and the terms of this Agreement bind the District and Applicant and their heirs, executors, administrators, personal representatives, successors, agents, attorneys, assigns, designees, and transferees.

The parties hereto have read and fully understand the above provisions and agree to comply with said provisions.

FALL CREEK REGIONAL WASTE DISTRICT

APPLICANT

Signature

Signature

STATE OF INDIANA)
) SS:
COUNTY OF MADISON)

SUBSCRIBED and sworn to before me this _____ day of _____, 20____

My Commission Expires:

Signature

Printed

Notary Public

Resident of _____ County


Inspector Tim Date Inspected 1-9-12 Approved ☒ Rejected ☐

Reason for Rejection

Date Reinspected _____ Approved ☐ Rejected ☐

Notes:

Size Pipe 4" Type Pipe SDR35
Basement Yes ☐ No ☒
Sump Pump Yes ☐ No ☒
Downspout to Ground Yes ☐ No ☒
Septic Tank Pumped & Filled Yes ☐ No ☒
Contractor Self
Special Conditions old House
Existing Home ☒
New Construction ☐

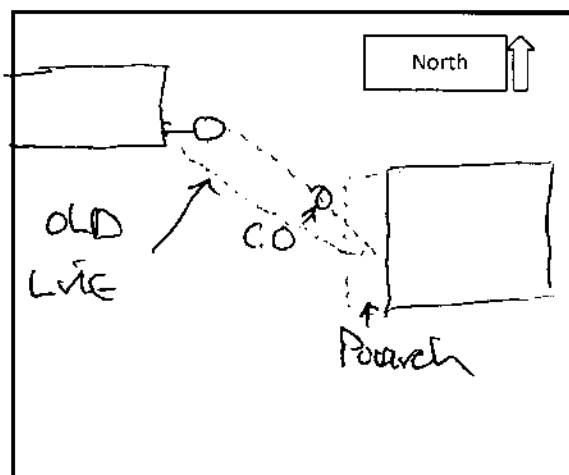

Replaced Lateral
From House To
Grinder Pit

GRAVEL LAWN CEMETERY CO.

317-485-5987
P.O. BOX 35
FORTVILLE, IN 46040

GREENFIELD BANKING COMPANY
71-367/749

7612

8/13/2002

PAY TO THE
ORDER OF

Fall Creek Regional Waste

\$ **2,635.00

Two Thousand Six Hundred Thirty-Five and 00/100*****

DOLLARS

Fall Creek Regional Waste

MEMO

TAP Fee & Capacity Fee for Sewer

⑈007612⑈ ⑆074903670⑆

Samuel E. Nock
Bonnie K. Osborn
AUTHORIZED SIGNATURE

GRAVEL LAWN CEMETERY CO.

Fall Creek Regional Waste

TAP Fee & Capacity Fee for Sewer

8/13/2002

2,635.00

7612

Greenfield Banking C TAP Fee & Capacity Fee for Sewer

2,635.00