

FALL CREEK REGIONAL WASTE DISTRICT

4256

9378 S 650 WEST, P.O. BOX 59, PENDLETON, IN 46064

765-778-7544

AGREEMENT FOR SANITARY SEWER SERVICE

This Agreement made and entered into this 16th day of April, 2001, between FALL CREEK REGIONAL WASTE DISTRICT ("District") and Jon & Julie Jackson ("Applicant") regarding the provision of sanitary sewer service, and the assignment of capacity in, and connection to, the District's facilities for the premises located at 908 Red Oak Lane.

NOW THEREFORE, the parties, in consideration of the mutual promises set out in this Agreement, the receipt and sufficiency of which is hereby acknowledged, agree as follows:

1. The Applicant agrees that all workmanship and materials shall conform to all District ordinances and the District's construction standards. District must accept and approve all work and materials before backfilling and final connection is made to the sewer main. Violation of this provision will cause all lines and appurtenances in violation to be removed at Applicant's expense.
2. The District shall have the right to enter upon the Applicant's premises at all reasonable times to inspect, repair, or replace any sewer line in connection with the District's service or which has an impact on said service.
3. The Applicant shall pay all monthly user rates, capacity charges, and tap fees. The failure to pay such charges shall constitute a lien against the property and/or the termination of service to the property, the cost of which shall be borne by Applicant, including, but not limited to, all attorney's fees and collection costs.
4. The District shall not be responsible for any damages as a result of any failure to supply service unless said damages are due to default, neglect or culpability on the part of the District.
5. If there is an available sanitary sewer within three hundred (300) feet of the property line, the property owner shall be required to connect to the District's sanitary sewer system.
6. The Applicant and District agree that the provision of sanitary sewer service touches and concerns the property and the terms of this Agreement bind the District and Applicant and their heirs, executors, administrators, personal representatives, successors, agents, attorneys, assigns, designees, and transferees.

The parties hereto have read and fully understand the above provisions and agree to comply with said provisions.

FALL CREEK REGIONAL WASTE DISTRICT
Julie Wilson
 Signature

APPLICANT
Julie Jackson
 Signature

STATE OF INDIANA)
) SS:
 COUNTY OF MADISON)

SUBSCRIBED and sworn to before me this 16th day of April, 2001.

My Commission Expires:
2-20-2008

Signature Deborah L. Wilson

Printed Deborah L. Wilson

Notary Public
 Resident of Madison County

 INSPECTOR Tim DATE INSPECTED 8-1-01 APPROVED ✓ REJECTED _____

REASON FOR REJECTION _____

DATE REINSPECTED _____ APPROVED _____ REJECTED _____

NOTES:
 SIZE PIPE 4" / 1 1/2 TYPE PIPE SOR 35 / 1 1/2 CTS

BASEMENT YES ✓ NO _____

SUMP PUMP YES ✓ NO _____

DOWNSPOUT TO GROUND YES ✓ NO _____


SEPTIC TANK PUMPED & FILLED YES ✓ NO _____

CONTRACTOR Royal Flush

SPECIAL CONDITIONS _____

EXISTING HOME ✓

NEW CONSTRUCTION _____

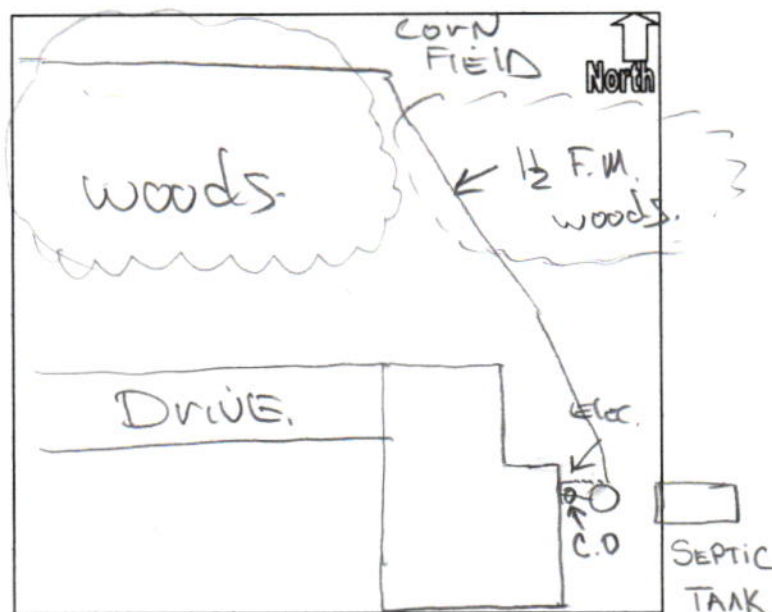

JON A JACKSON 2-97
JULIE JACKSON
908 RED OAK LN
PENDLETON, IN 46064-9379
(765) 778-7481

1850

DATE

April 16, 01

71-167749
BRANCH 10006

PAY TO THE
ORDER OF

Fall Creek Regional Waste

\$ 3,580. ⁰⁰/₁₀₀

Three thousand five hundred eighty and 00/100

DOLLARS

Security features
included.
Details on back.



FOR

Julie Jackson

⑆074901672⑆1850