


4648

765-778-7544

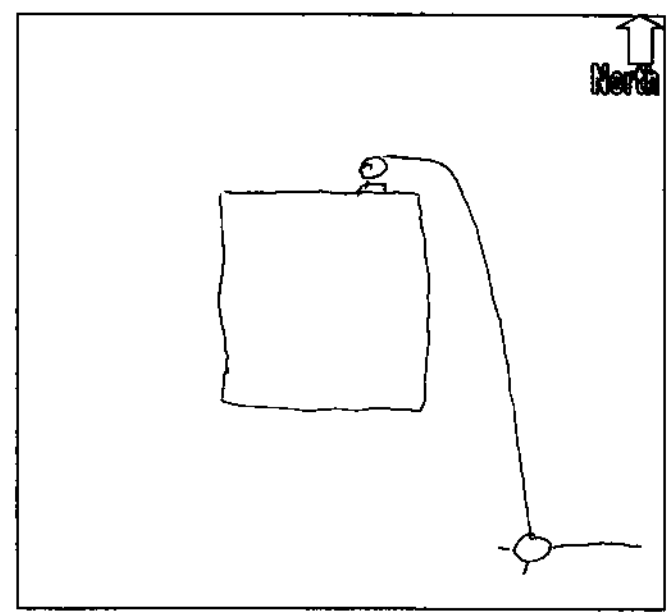

TAP-ON Fee - 475.⁰⁰
C. B. OR ANITA FAULK Compacity Fee - 2160.⁰⁰
9139 S. 650 W. 778-3648 grinder = 1024.80 (9-18-02)
BENDLETON, IN 46064 Date

3812

71-7258/2749
00

Pay to the
Order of

Fall Creek Regional Waste
Three thousand and no/100ths
\$ 3659.⁸⁰
Dollars

FEDERAL CREDIT UNION
100 WEST 20TH STREET - ANDERSON, INDIANA 46016

FOR (Fee) (Grinder) Charles B. Faulk

⑆ 270972582⑆

3812



FALL CREEK REGIONAL WASTE DISTRICT

P.O. Box 59 • 9378 S. 650 West • Pendleton, Indiana 46064-0059 • (765) 778-7544

August 23, 2004

Mr. C.B Faulk
9139 S 650 W
Pendleton, IN 46064

Dear Mr. Faulk:

Recently the Fall Creek Regional Waste District (FCRWD) was pleased to announce that a Community Focus Fund Grant has been awarded to the Town of Ingalls with FCRWD as a sub recipient by the Indiana Department of Commerce to fund construction of a wastewater collection system for the areas of Green Township known as County Roads 650 West, 750 West, 760 West, 900 South, 920 South, 800 West, 800 South, 875 South, Fall Creek Drive (between CR 650 W and CR 750 W), and Carefree Community Homes.

As Fall Creek Regional Waste District promised and as a result of the grant, residents in these areas will not be charged any connection fees and will be provided a residential wastewater grinder unit at no cost when they connect their homes to the sanitary system.

Enclosed please find a check in the amount of \$3,659.80 as reimbursement of your connection fees and the cost of your wastewater grinder unit.

Thank you for your support of our successful grant efforts.

Sincerely,

Teresa K. Hutton
Office Manager

| DATE | REFERENCE : INVOICE NO. | APV NUMBER | INVOICE AMOUNT | BALANCE |
|------|-------------------------|------------|----------------|---------|
|------|-------------------------|------------|----------------|---------|

8/23/04

refund of connection fees & grinder
per Grant Agreement \$3,659.80

| | |
|--------------|-----------|
| Tap Fee | \$475.00 |
| Capacity Fee | \$2160.00 |
| Grinder | \$976.00 |
| Tax | \$48.80 |

BOYCE FORMS - 800-382-8702

FALL CREEK REGIONAL WASTE DISTRICT
PENDLETON, INDIANA 46061

019412

| DATE | CHECK NUMBER | FUND | PAY EXACTLY |
|---------|--------------|------|--------------|
| 8/23/04 | 19412 | 100 | *\$3,659.80* |

C.B. Faulk

MADISON COUNTY CITY BANK
PENDLETON, INDIANA

Don & M. A.

TREASURER

019412 0749055391