



FALL CREEK REGIONAL WASTE DISTRICT

Box 44, Pendleton, Indiana 46064

2-0008640.00

No 001308

APPLICATION FOR SEWER PERMIT

Permit No. _____ Date 2-4-86
Permit Void 90 days from Date of Issuance
Owner Name JANICE PETERSON
Property Address 913 SLACK DR
Lot # _____ P.O. Box _____
Town ANDERSON, IN Zip Code 46013
Phone 644-6729 Water Meter _____
\$ 15000 Tap on Fee Paid
\$ 2500 Inspection fee paid

Application is hereby made for connection to the Fall Creek Regional Waste District Sewer System for the above listed property - Permit Type: Residential [checked], Commercial _____, Industrial _____, or Governmental/Institutional _____.

All workmanship and materials shall conform to the standards of the District Ordinance as described in Ordinance 84-2 and 84-3 as amended. Acceptance and approval must be made by the District inspector or his duly authorized representative before backfilling and final connection is made to the main sewer lines.

The Fall Creek Regional Waste District is responsible for the inspection, approval of materials, and installation techniques only. All costs for materials and installation and any liabilities resulting from same is the sole responsibility of the property owner.

I have read and fully understand the above provisions and agree to comply by said provisions.

APPLICANT(S) SIGNATURE


INSPECTOR [Signature]

Date inspected 2-20 Approved [Signature] Rejected _____

Reason for rejection _____

Date reinspected _____ Approved _____ Rejected _____

Notes:
Size Pipe 6"
Type Pipe PVC
Basement Yes No [X]
Sump Pump Yes No [X]
Downspout to Ground Yes [X] No
Septic Tank Pumped & filled Yes No
Contractor FLATFORD
Special Conditions WATER AT TAP

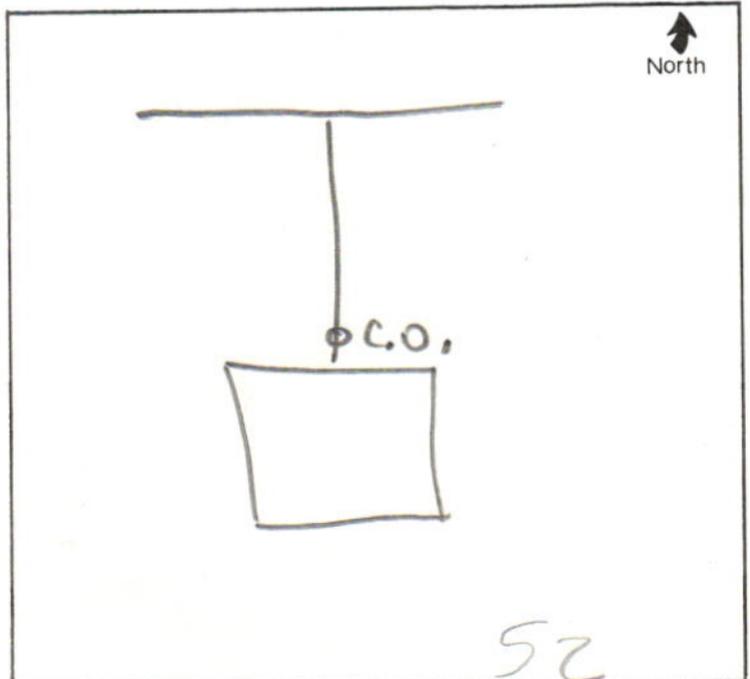

52