



FALL CREEK REGIONAL WASTE DISTRICT

Box 44, Pendleton, Indiana 46064

22-05080.01

2-0005080.01

Nº 001672

APPLICATION FOR SEWER PERMIT

Permit No. _____ Date 4-18-89

Permit Void 90 days from Date of Issuance

Owner Name JACK & Kathy Stevens

Property Address R4 Box 236

916 Weyboort

Lot # _____ P.O. Box _____

Town PENDLETON, IN Zip Code 46064

Phone 778-4682 Water Meter —"

\$ 500.00 Tap on Fee Paid

\$ 25.00 Inspection fee paid

Application is hereby made for connection to the Fall Creek Regional Waste District Sewer System for the above listed property - Permit Type: Residential X, Commercial _____, Industrial _____, or Governmental/Institutional _____. User Information _____.

All workmanship and materials shall conform to the standards of the District Ordinance as described in Ordinance 84-2 and 84-3 as amended. Acceptance and approval must be made by the District inspector or his duly authorized representative before backfilling and final connection is made to the main sewer lines. Any violation of applicable regulations will cause all lines and appurtenances in violation to be removed and replaced at the owners expense.

The Fall Creek Regional Waste District is responsible for the inspection, approval of materials, and installation techniques only. All costs for materials and installation and any liabilities resulting from same is the sole responsibility of the property owner.

I have read and fully understand the above provisions and agree to comply by said provisions.

APPLICANT(S) SIGNATURE

INSPECTOR BS

Date inspected 4-24-89 Approved _____ Rejected _____

Reason for rejection _____

Date reinspected _____ Approved _____ Rejected _____

Notes:

Size Pipe 6"

Type Pipe PVC

Basement Yes _____ No X


Sump Pump Yes _____ No X

Downspout to Ground Yes _____ No X

Septic Tank Pumped & filled Yes X No _____

Contractor EARL DAVIS

Special Conditions _____

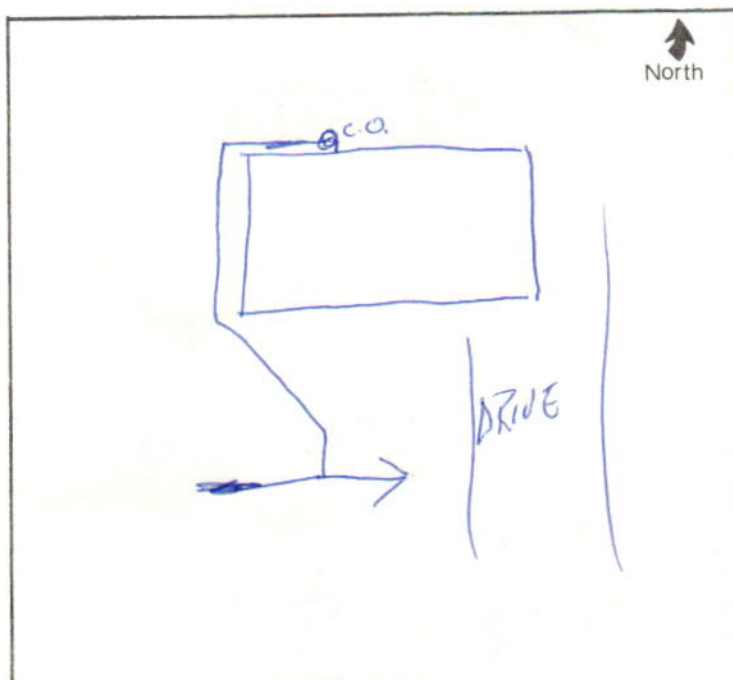

To

Mr. & Mrs. Stevens

RP#4 Box 236

Pendleton, IN 46064

Fall Creek Regional Waste District

P.O. Box 59, C.R. 650 West
Pendleton, Indiana 46064-0059
(317) 778-3983

Subject

Date 4 / 18 / 89

MESSAGE

Enclosed please find a copy of your sewer permit and a receipt for your \$525.00. I have also enclosed our regulation sheet to give you some information on installation. Jerry Cox's phone number is 642-4121. Your tap is located 270 feet from the manhole at ditch (Bob Owens property) 10.5 feet from our mainline. 5 Feet deep. Whoever does your connection will need these numbers. They can also come in and look at the maps. Earl Davis' phone number is 778-2011. Call again if you have questions.

Signed

Teresa Hutton