


Pool House Springbrook Baldwin Ex 4-1-22



Lot 194 Larson Dr ~~Spring~~ Baldwin Ex 4-1-22.



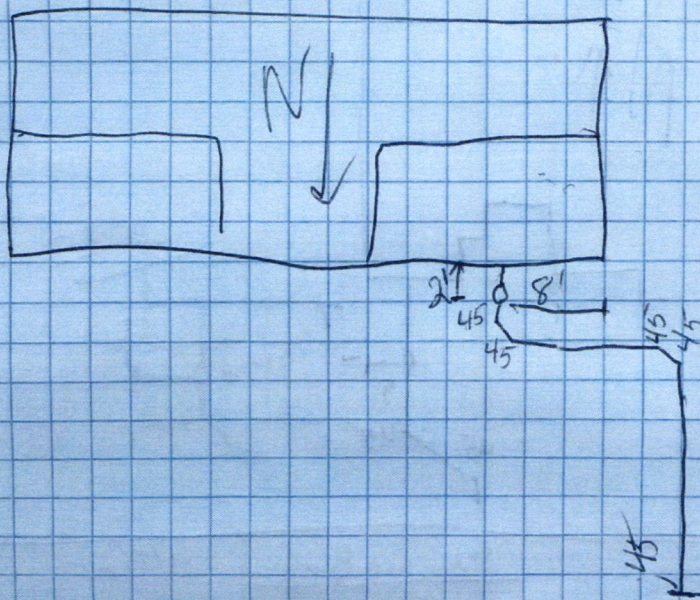



Lennar Corporation
Lennar Homes of Indiana, Inc.
Indianapolis Division
11555 N Meridian St Ste 400
Carmel, IN 46032

CHECK
NUMBER 1708772

70-2322
719

November 8, 2021


*** VOID AFTER 180 DAYS ***

PAY TO THE ORDER OF: FALL CREEK REGIONAL WASTE DISTRICT
PO BOX 59
PENDLETON, IN 46064

CHECK AMOUNT

\$4,160.00

EXACTLY *****4,160 DOLLARS AND 00 CENTS

 Security features
included.
Details on back.

JPMorgan Chase Bank, N.A.
Chicago, IL



Authorized Signature

Rec # 011931