

Fall Creek Regional Waste District  
9378 S 650 W, P.O. Box 59, Pendleton, IN 46064  
765-778-7544

#7030

Agreement for Sanitary Sewer Service

This Agreement made and entered into this \_\_\_\_ day of \_\_\_\_\_, 20\_\_\_\_, between Fall Creek Regional Waste District ("District") and LENNAR HOMES ("Applicant") regarding the provision of sanitary sewer service, and the assignment of capacity in and connection to, the District's facilities for the premises located at SPRINGBROOK LOT 7.

Street Address: 9182 Springbrook Dr.

Now therefore, the parties, in consideration of the mutual promises set out in this Agreement, the receipt and sufficiency of which is hereby acknowledged, agree as follows:

1. The Applicant agrees that all workmanship and materials shall conform to all District ordinances and the District's construction standards. District must accept and approve all work and materials before backfilling and final connection is made to the sewer mains. Any violation of this provision will cause all lines and appurtenances in violation to be removed and replaced at the Applicant's expense.
2. The District shall have the right to enter upon the Applicant's premises at all reasonable times to inspect, repair, or replace any equipment used in connection with the District's service or which has an impact on said service.
3. The Applicant shall be responsible for all monthly user rates, capacity charges, and tap fees. The failure to pay any rate charge or fee may result in a lien against the property and/or the termination of service to the property, the cost of which will be borne by Applicant, including, but not limited to, all attorney's fees and collection costs.
4. The District shall not be responsible for any damages as a result of any failure to supply service unless said damages are due to default, neglect or culpability on the part of the District.
5. If there is an available sanitary sewer within three hundred (300) feet of the property line, the property owner shall be required to connect to the District's sanitary sewer system.
6. The Applicant and District agree that the provision of sanitary sewer service touches and concerns the property and the terms of this Agreement bind the District and Applicant and their heirs, executors, administrators, personal representatives, successors, agents, attorneys, assigns, designees, and transferees.

The parties hereto have read and fully understand the above provisions and agree to comply with said provisions.

FALL CREEK REGIONAL WASTE DISTRICT

APPLICANT

Signature

Signature

STATE OF INDIANA )  
 ) SS:  
COUNTY OF MADISON )

SUBSCRIBED and sworn to before me this \_\_\_\_ day of \_\_\_\_\_, 20\_\_\_\_

My Commission Expires:

Signature

Printed

Notary Public

Resident of \_\_\_\_\_ County

\*\*\*\*\*

Inspector DH Date Inspected 1-24-20 Approved ☒ Rejected ☐  
Reason for Rejection \_\_\_\_\_

Date Reinspected \_\_\_\_\_ Approved \_\_\_\_\_ Rejected \_\_\_\_\_

Notes:

Size Pipe 6" Type Pipe PVC 35

Basement Yes ☒ No ☐

Sump Pump Yes ☒ No ☐

Downspout to Ground Yes ☒ No ☐


Septic Tank Pumped & Filled Yes ☒ No ☐

Contractor JALDWIN

Special Conditions \_\_\_\_\_

Existing Home ☐

New Construction ☒

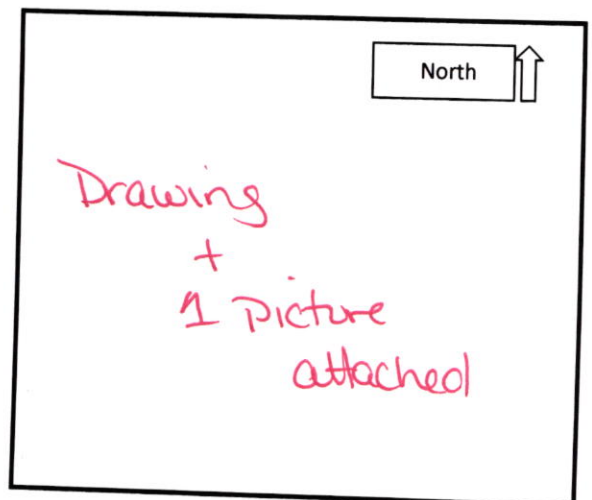

#7020

## Agreement for Sanitary Sewer Service

Street Address: 9182 Springbrook Dr. Pendleton, IN 46064


1. The Applicant agrees that all workmanship and materials shall conform to all District ordinances and the District's construction standards. District must accept and approve all work and materials before backfilling and final connection is made to the sewer mains. Any violation of this provision will cause all lines and appurtenances in violation to be removed and replaced at the Applicant's expense.
2. The District shall have the right to enter upon the Applicant's premises at all reasonable times to inspect, repair, or replace any equipment used in connection with the District's service or which has an impact on said service.
3. The Applicant shall be responsible for all monthly user rates, capacity charges, and tap fees. The failure to pay any rate charge or fee may result in a lien against the property and/or the termination of service to the property, the cost of which will be borne by Applicant, including, but not limited to, all attorney's fees and collection costs.
4. The District shall not be responsible for any damages as a result of any failure to supply service unless said damages are due to default, neglect or culpability on the part of the District.
5. If there is an available sanitary sewer within three hundred (300) feet of the property line, the property owner shall be required to connect to the District's sanitary sewer system.
6. The Applicant and District agree that the provision of sanitary sewer service touches and concerns the property and the terms of this Agreement bind the District and Applicant and their heirs, executors, administrators, personal representatives, successors, agents, attorneys, assigns, designees, and transferees.

FALL CREEK REGIONAL WASTE DISTRICT  
Signature Rachel Tany

APPLICANT   
Signature

[illegible]

SUBSCRIBED and sworn to before me this 2 day of Dec., 20 19

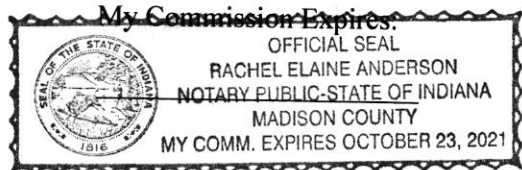


Signature Rachel E. Anderson  
Printed Rachel E. Anderson  
Notary Public  
Resident of Madison County

Inspector \_\_\_\_\_ Date Inspected \_\_\_\_\_ Approved \_\_\_\_\_ Rejected \_\_\_\_\_  
Reason for Rejection \_\_\_\_\_  
Date Reinspected \_\_\_\_\_ Approved \_\_\_\_\_ Rejected \_\_\_\_\_  
Notes: \_\_\_\_\_

**Notes:**

Size Pipe \_\_\_\_\_ Type Pipe \_\_\_\_\_  
 Basement Yes No  
 Sump Pump Yes No  
 Downspout to Ground Yes No  
 Septic Tank Pumped & Filled Yes No  
 Contractor \_\_\_\_\_  
 Special Conditions \_\_\_\_\_  
 Existing Home \_\_\_\_\_  
 New Construction \_\_\_\_\_

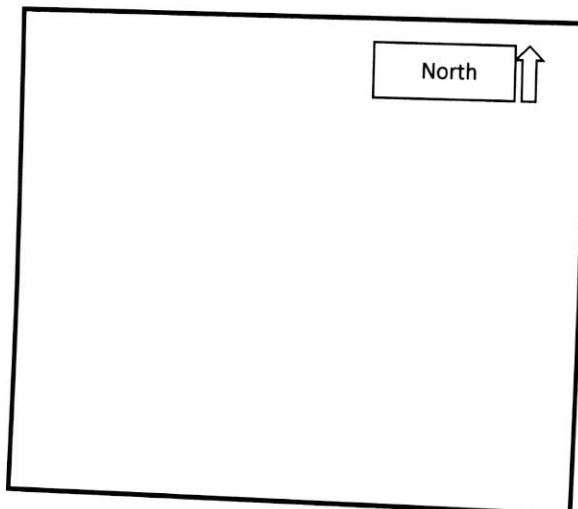





# STOEPPELWERTH

ALWAYS ON

7965 East 106th Street, Fishers, IN 46038-2505  
phone: 317.849.5935 fax: 317.849.5942

JOB ID SPRINGBK1A.7

CONTROL# 89712 LEN

9182 SPRINGBROOK DRIVE  
PENDLETON, IN 46064


1" = 30'

LOT AREA: 8,710 Sq. Ft.

CONTRACTOR SHALL CUT 18' OFF OF LATERAL AND  
BEGIN FROM THAT POINT AND CONNECT TO HOUSE  
FOLLOWING PLOT PLAN.

M.F.F.E.=864.6

M.F.P.G.=864.2

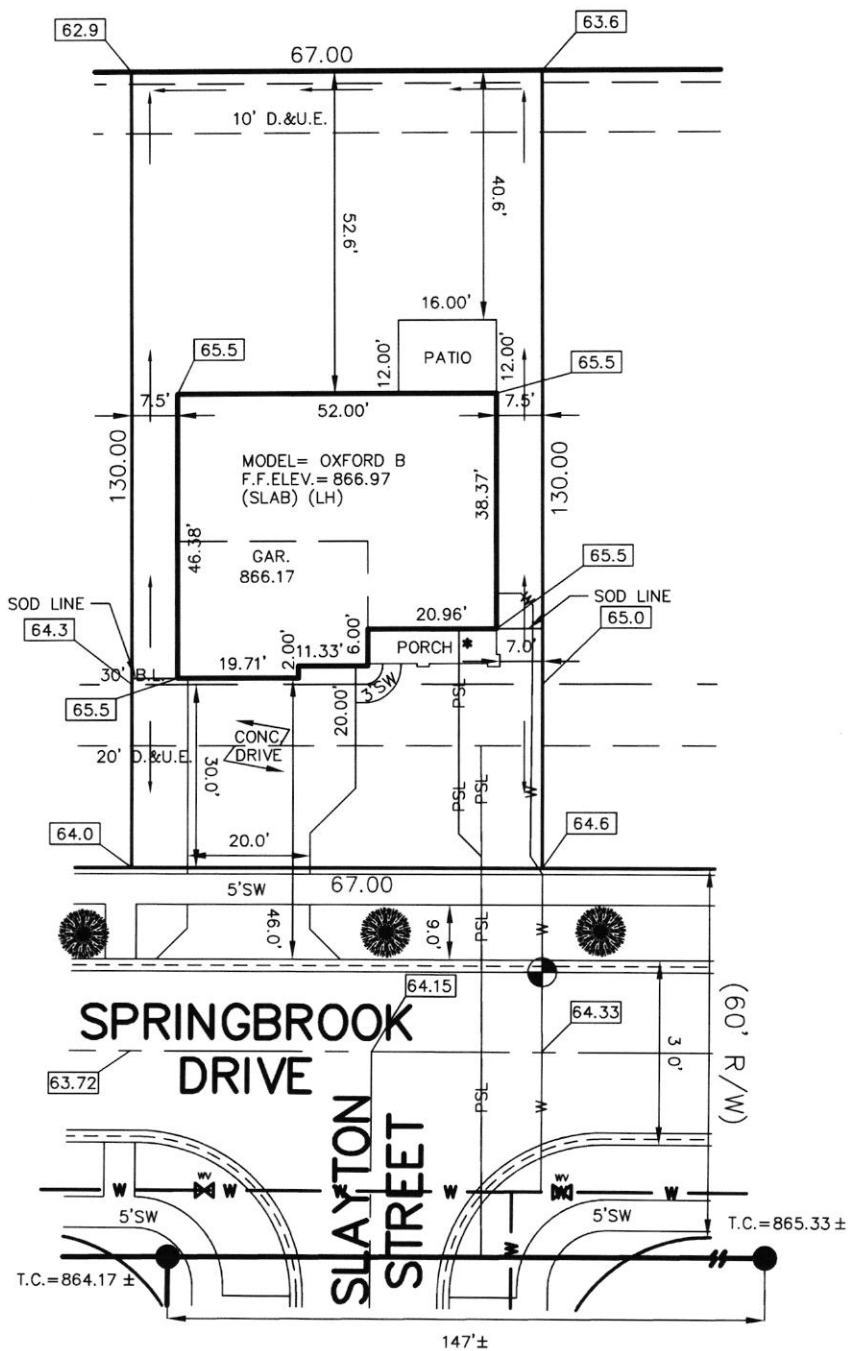


#### LEGEND:

XX.X PROPOSED GRADE PER PLAN  
XX.XAB AS BUILT GRADE

S.S.D. SUB-SURFACE DRAIN  
SANITARY SEWER  
6" AS BUILT SANITARY LATERAL  
6" PROPOSED SANITARY LATERAL  
STORM SEWER  
W WATER MAIN  
3/4" WATER CONNECTION  
SWALE

● SANITARY MANHOLE  
● STORM MANHOLE  
■ CURB INLET  
● FIRE HYDRANT  
● STREET TREES  
WV WATER VALVE

D.&U.E. DRAINAGE & UTILITY EASEMENT  
B.L. BUILDING LINE  
M.F.P.G. MINIMUM FLOOD PROTECTION  
GRADE  
M.F.F.E. MINIMUM FINISHED FLOOR ELEVATION

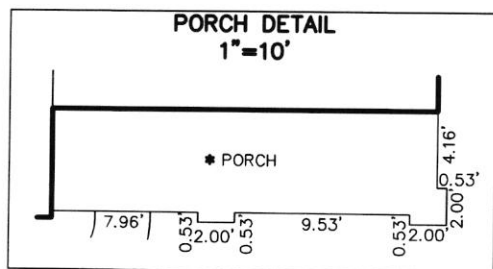

BENCHMARK

TOP OF CURB = 864.33

LOT 7  
SPRINGBROOK  
SECTION 1A  
INST. #2019R014444  
ZONING: R3  
5' MINIMUM SIDE YARD  
30' MINIMUM FRONT YARD  
15' MINIMUM REAR YARD

SOD: 202 ± Sq. Yd.  
SEEDING: 3,970 ± Sq. Ft.  
SEED IN EASEMENT: 670 ± Sq. Ft.  
CONC. DRIVEWAY: 817 ± Sq. Ft.  
PRIVATE WALK: 27 ± Sq. Ft.  
PUBLIC WALK: 242 ± Sq. Ft.  
APRON: 305 ± Sq. Ft.  
ADDITIONAL SOD TO: 367 ± Sq. Yd.  
REAR EASEMENT  
HANDICAP RAMPS:

1



David J. Stoepfelwerth

NOTE: THIS DRAWING IS NOT INTENDED TO BE  
REPRESENTED AS A RETRACEMENT OR ORIGINAL  
BOUNDARY SURVEY, A ROUTE SURVEY OR A  
SURVEYOR LOCATION REPORT.


11/15/19 JOB





1-24-20  
SPRINGBROOK  
LOT 7

SPRINGBROOK DR.

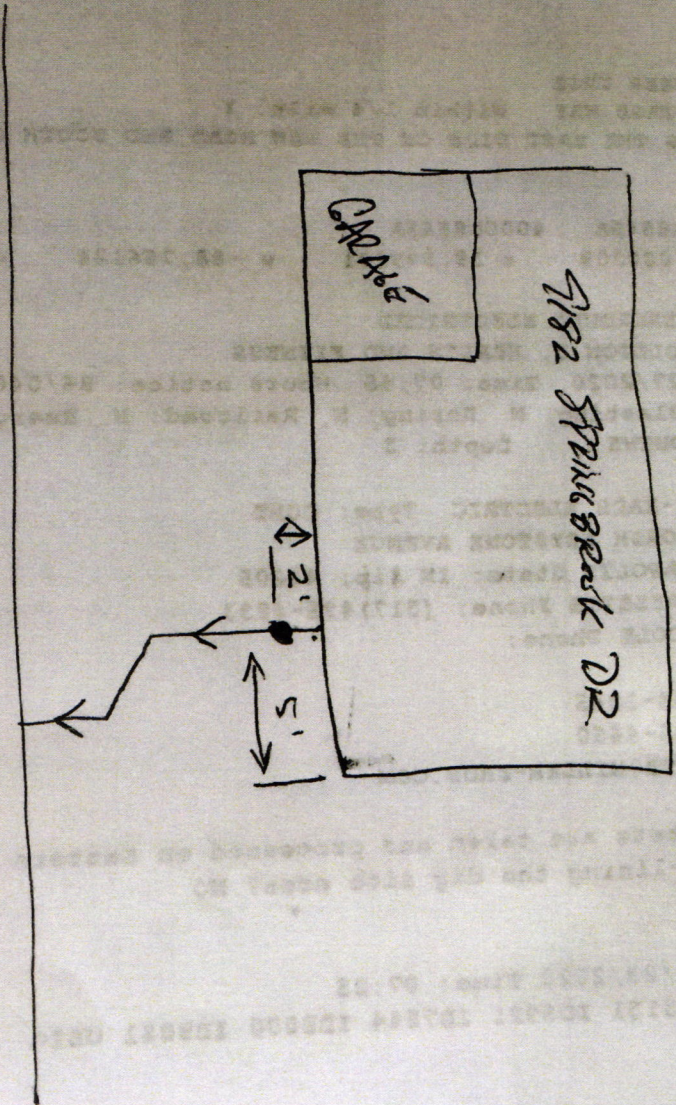







COPY

DO NOT ACCEPT THIS CHECK UNLESS YOU CAN SEE A DUAL-TONE TRUE WATERMARK THAT APPEARS AS A CHAIN LINK PATTERN WHEN HELD TO THE LIGHT.

Lennar Homes of Indiana Inc  
9025 N River Rd Ste 100

JPMorgan Chase Bank N.A.  
Chicago, IL

01336102

Indianapolis, IN 46240

Void if over 180 days

70-2322  
719

PAY

DATE	AMOUNT
11/18/19	\$*****570.00

FIVE HUNDRED SEVENTY AND 00/100 \*\*\*\*\*

DOLLARS

TO THE ORDER OF  
Fall Creek Regional Waste District  
PO Box 59  
Pendleton IN 46064

*Dane Bessette*  
Authorized Signatory

Authorized Signatory  
Two Signatures Required on Amounts Over \$100,000.00

THE FACE OF THIS CHECK HAS A BLUE AND GREEN BACKGROUND - ANY OTHER COLORS MAY BE EVIDENCE OF CHEMICAL ALTERATION OR ERASURE - SEE REVERSE SIDE FOR MORE SAFETY FEATURES.

Rec # 011073