

Matthew Borrusel

FALL CREEK REGIONAL WASTE DISTRICT

9378 S 650 WEST, P.O. BOX 59, PENDLETON, IN 46064

765-778-7544

4947

21-063/5.00

AGREEMENT FOR SANITARY SEWER SERVICE

This Agreement made and entered into this 21<sup>st</sup> day of August, 2003, between FALL CREEK REGIONAL WASTE DISTRICT ("District") and C.P. Morgan ("Applicant") regarding the provision of sanitary sewer service, and the assignment of capacity in, and connection to, the District's facilities for the premises located at Lot #63 Summerlake  
9186 W. Lodge Lane

NOW THEREFORE, the parties, in consideration of the mutual promises set out in this Agreement, the receipt and sufficiency of which is hereby acknowledged, agree as follows:

1. The Applicant agrees that all workmanship and materials shall conform to all District ordinances and the District's construction standards. District must accept and approve all work and materials before backfilling and final connection is made to the sewer mains. Any violation of this provision will cause all lines and appurtenances in violation to be removed and replaced at the Applicant's expense.

2. The District shall have the right to enter upon the Applicant's premises at all reasonable times to inspect, repair, or replace any equipment used in connection with the District's service or which has an impact on said service.

3. The Applicant shall be responsible for all monthly user rates, capacity charges, and tap fees. The failure to pay any rate charge or fee may result in a lien against the property and/or the termination of service to the property, the cost of which will be borne by Applicant, including, but not limited to, all attorney's fees and collection costs.

4. The District shall not be responsible for any damages as a result of any failure to supply service unless said damages are due to default, neglect or culpability on the part of the District.

5. If there is an available sanitary sewer within three hundred (300) feet of the property line, the property owner shall be required to connect to the District's sanitary sewer system.

6. The Applicant and District agree that the provision of sanitary sewer service touches and concerns the property and the terms of this Agreement bind the District and Applicant and their heirs, executors, administrators, personal representatives, successors, agents, attorneys, assigns, designees, and transferees.

The parties hereto have read and fully understand the above provisions and agree to comply with said provisions.

FALL CREEK REGIONAL WASTE DISTRICT

Signature

Jan E. Carey

APPLICANT

Signature

Deborah Green

STATE OF INDIANA )

) SS:

COUNTY OF MADISON )

SUBSCRIBED and sworn to before me this 21<sup>st</sup> day of August, 2003.

My Commission Expires:

4-29-09

Signature

Printed

Notary Public

Resident of Madison County

Jan E. Carey

Jan E. Carey

\*\*\*\*\*  
INSPECTOR Bu DATE INSPECTED 8-26-03 APPROVED ✓ REJECTED \_\_\_\_\_

REASON FOR REJECTION \_\_\_\_\_

DATE REINSPECTED \_\_\_\_\_ APPROVED \_\_\_\_\_ REJECTED \_\_\_\_\_

NOTES:

SIZE PIPE 6

TYPE PIPE PVC

BASEMENT YES \_\_\_\_\_ NO ✓

SUMP PUMP YES \_\_\_\_\_ NO ✓

DOWNSPOUT TO GROUND YES ✓ NO \_\_\_\_\_


SEPTIC TANK PUMPED & FILLED YES \_\_\_\_\_ NO ✓

CONTRACTOR Betty

SPECIAL CONDITIONS \_\_\_\_\_

EXISTING HOME \_\_\_\_\_

NEW CONSTRUCTION ✓

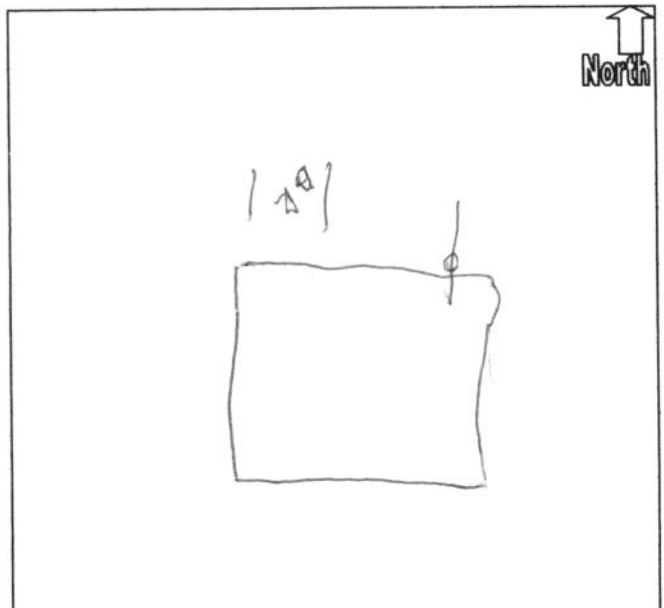

11-16-12  
11-16-12

FALL CREEK REGIONAL WASTE DISTRICT  
200 WEST 10th ST. DENVER, CO 80202

11

1. The purpose of this agreement is to establish a framework for the management and disposal of solid waste within the Fall Creek Regional Waste District. This agreement shall be entered into by and between the District and the County of Denver, Colorado.

2. The District shall be responsible for the collection, transportation, and disposal of solid waste within its jurisdiction. The County shall be responsible for the collection, transportation, and disposal of solid waste within its jurisdiction.

3. The District shall be responsible for the maintenance and operation of its waste management facilities. The County shall be responsible for the maintenance and operation of its waste management facilities.


4. The District shall be responsible for the payment of the costs of waste management services provided by the County. The County shall be responsible for the payment of the costs of waste management services provided by the District.

5. This agreement shall be entered into by and between the District and the County of Denver, Colorado.



11-16-12  
11-16-12

FALL CREEK REGIONAL WASTE DISTRICT  
200 WEST 10th ST. DENVER, CO 80202

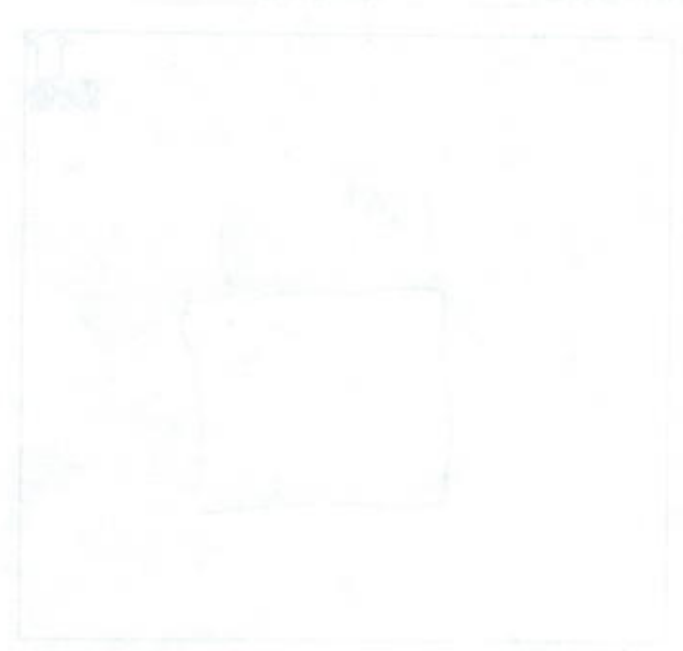

29013

C.P. MORGAN COMMUNITIES, LP  
CONSTRUCTION ACCOUNT

BANK ONE, NA  
INDIANAPOLIS, INDIANA 46277  
20-1-740

8-20-03

PAY TO THE  
ORDER OF

FALL CREEK REGIONAL WASTEWATER

\$2635.00

Two Thousand Six Hundred Thirty Five and  $\frac{00}{100}$  DOLLARS

MEMO

SU 63

Matthew Borrusel

*[Signature]*

MP

⑈029013⑈

⑈074000010⑈

705001387194⑈