#8244


Fall Creek Regional Waste District 9378 S 650 W, P.O. Box 59, Pendleton, IN 46064 765-778-7544

Agreement for Sanitary Sewer Service

| This Agreement made and entered into this 7 day of January , 20 22, between Fall Creek Regional Waste District ("District") and Lennar Homes ("Applicant") regarding the provision of sanitary sewer service, and the assignment of capacity in and connection to, the District's facilities for the premises located at Springbrook Lot 287 | | | | | | |
|--|--|--|--|--|--|--|
| Street Address: 9193 Larson DR. Pendleton | | | | | | |
| Now therefore, the parties, in consideration of the mutual promises set out in this Agreement, the receipt and sufficiency of which is hereby acknowledged, agree as follows: | | | | | | |
| The Applicant agrees that all workmanship and materials shall conform to all District ordinances and the District's construction standards. District must accept and approve all work and materials before backfilling and final connection is made to the sewer mains. Any violation of this provision will cause all lines and appurtenances in violation to be removed and replaced at the Applicant's expense. The District shall have the right to enter upon the Applicant's premises at all reasonable times to inspect, repair, or replace any equipment used in connection with the District's service or which has an impact on said service. The Applicant shall be responsible for all monthly user rates, capacity charges, and tap fees. The failure to pay any rate charge or fee may result in a lien against the property and/or the termination of service to the property, the cost of which will be borne by Applicant, including, but not limited to, all attorney's fees and collection costs. The District shall not be responsible for any damages as a result of any failure to supply service unless said damages are due to default, neglect or culpability on the part of the District. If there is an available sanitary sewer within three hundred (300) feet of the property line, the property owner shall be required to connect to the District's sanitary sewer system. The Applicant and District agree that the provision of sanitary sewer service touches and concerns the property and the terms of this Agreement bind the District and Applicant and their heirs, executors, administrators, personal representatives, successors, agents, attorneys, assigns, | | | | | | |
| designees, and transferees. The parties hereto have read and fully understand the above provisions and agree to comply with said provisions. | | | | | | |
| FALL CREEK REGIONAL WASTE DISTRICT Signature APPLICANT Signature | | | | | | |
| STATE OF INDIANA) | | | | | | |
|) SS: COUNTY OF MADISON) | | | | | | |
| SUBSCRIBED and sworn to before me this day of, 20 | | | | | | |
| My Commission Expires: Signature | | | | | | |
| Printed Notary Public Resident of County *********************************** | | | | | | |
| Inspector / Date Inspected 8 25/22 Approved Rejected Rejected Rejected | | | | | | |
| Notes: Size Pipe 6 Type Pipe 5D/2 35 Basement Yes No Sump Pump Yes No Downspout to Ground Yes No Contractor 13 allowing Existing Home New Construction 1 Product Approved Rejected North Nor | | | | | | |

STOEPPELWERTH

7965 East 106th Street, Fishers, IN 46038-2505 phone: 317.849.5935 fax: 317.849.5942

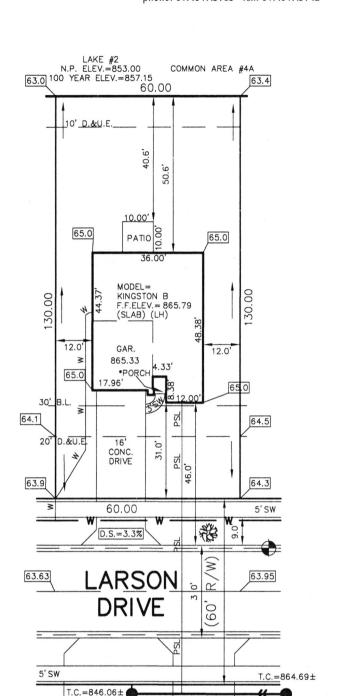

JOB ID SPRINGBK6.287

CONTROL# 104579 LEN

PARCEL# N/A

9193 LARSON DRIVE PENDLETON, IN 46064



1" = 30'

LOT AREA: 7,800 Sq. Ft.

> M.F.F.E.=864.2 M.F.P.G.=863.9

LEGEND: XX.XAB

PROPOSED GRADE PER PLAN

AS BUILT GRADE

S.S.D. SUB-SURFACE DRAIN ASL W W

SANITARY SEWER
6" AS BUILT SANITARY LATERAL
6" PROPOSED SANITARY LATERAL
STORM SEWER

3/4" WATER CONNECTION WATER MAIN

SWALE

SANITARY MANHOLE



STORM MANHOLE



CURB INLET

STREET TREE

D.&U.E.

M.F.P.G.

DRAINAGE & UTILITY EASEMENT

BUILDING LINE B.L. M.F.F.E.

MINIMUM FINISHED FLOOR ELEVATION MINIMUM FLOOD PROTECTION

ALL UNDERGROUND SEWERS AND UTILITIES SHOWN ARE PLOTTED BY SCALE FROM DESIGN PLANS FURNISHED BY ENGINEER THE ACTUAL FIELD LOCATION MAY VARY.


ALL UNDERGROUND SEWERS AND UTILITIES SHOWN ARE PLOTTED BY SCALE FROM DESIGN PLANS FURNISHED BY ENGINEER THE ACTUAL FIELD LOCATION MAY VARY.

BENCHMARK TOP OF CURB=863.95

LOT 287 SPRINGBROOK SECTION 6 INST. #2022R011165

ZONING: R3 5' MINIMUM SIDE YARD

30' MINIMUM FRONT YARD 15' MINIMUM REAR YARD

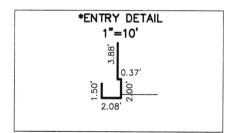

653 ± N/A ± 672 ± 23 ± 218 ± 153 ± SOD: SEED: Sq. Sq. Sq. Sq. Sq. CONC. DRIVEWAY:
PRIVATE WALK:
PUBLIC WALK:
APRON:
ADDITIONAL SOD:
HANDICAP RAMPS:

SIGNATURE:

180'±

DATE:


SIGNATURE REPRESENTS CONFIRMATION OF RECEIPT OF PLOT PLAN BY CUSTOMER




David J. Stoeppelwerth

OTE: THIS DRAWING IS NOT INTENDED TO BE REPRESENTED AS A RETRACEMENT OR ORIGINAL BOUNDARY SURVEY, A ROUTE SURVEY OR A SURVEYOR LOCATION REPORT.



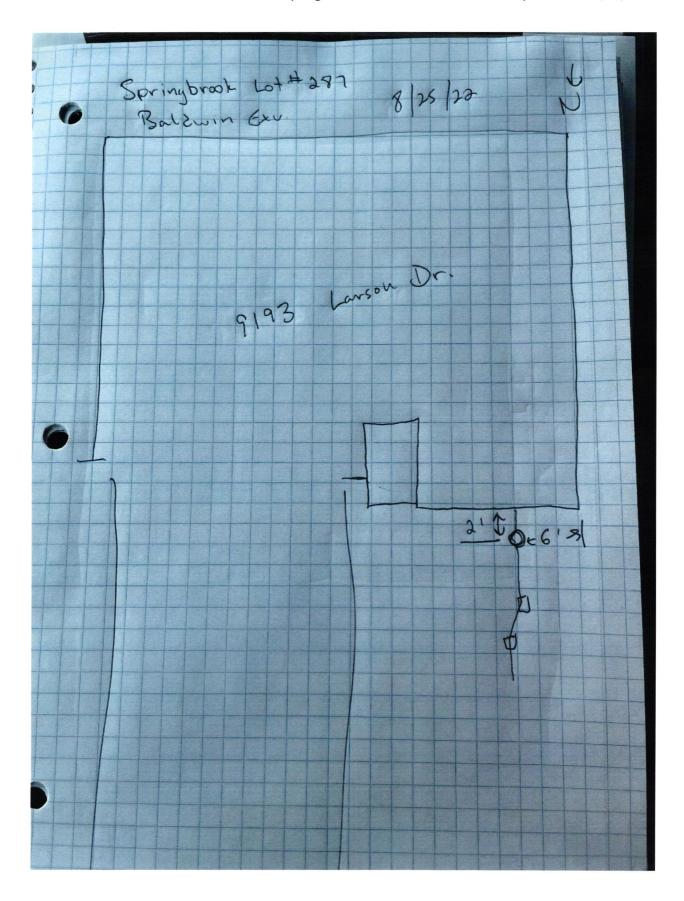

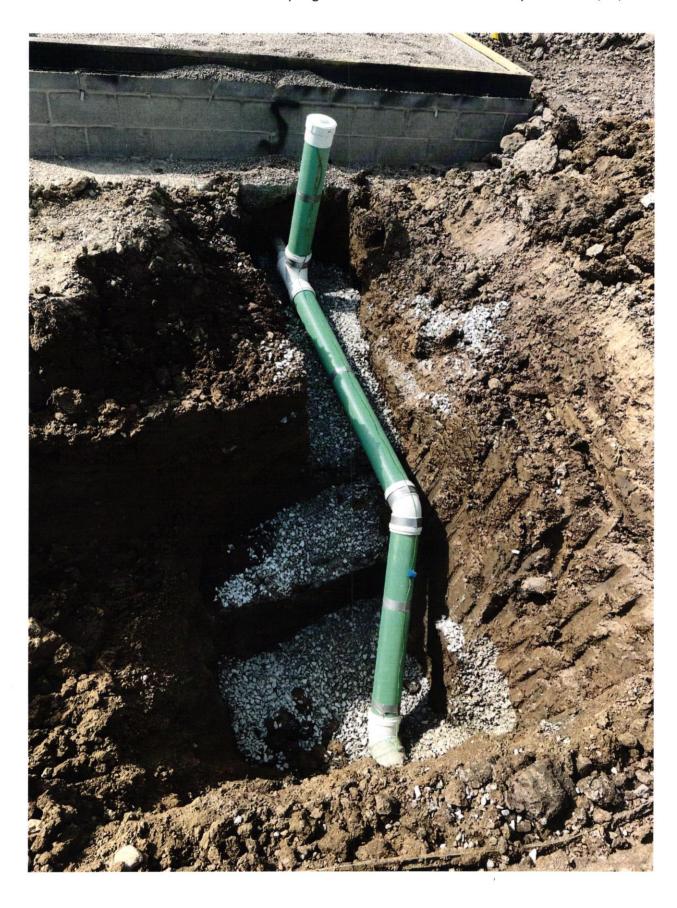

Lennar Corporation Lennar Homes of Indiana, LLC Indianapolis Division 11555 N Meridian St Ste 400 Carmle, IN 46032



C618465521846552

PAGE: 1 of 1

DATE: July 18, 2022 CHECK NUMBER: 1846552 AMOUNT PAID: \$760.00



00007 4346 CKS SD 22199 - 0001846552 NNNNNNNNN 1995100004203 XIP3C6 C FALL CREEK REGIONAL WASTE DISTRICT PO BOX 59 PENDLETON IN 46064

Vendor No: 12975753

| Date | CO. # | Invoice Number | Payment Advice | Gross Amount | Discount | Net Amount |
|----------|-------|----------------|-------------------|--------------|----------|------------|
| 07/07/22 | 69365 | 69365710287 WS | MV-69365710287 WS | \$760.00 | \$0.00 | \$760.00 |
| TOTALS | | | \$760.00 | \$0.00 | \$760.00 | |

PLEASE DETACH BEFORE DEPOSITING CHECK

Lennar Corporation Lennar Homes of Indiana, LLC Indianapolis Division 11555 N Meridian St Ste 400 Carmle, IN 46032

CHECK NUMBER

1846552

70-2322 719

July 18, 2022

*** VOID AFTER 180 DAYS ***

TO THE

PAY

FALL CREEK REGIONAL WASTE DISTRICT

PO BOX 59 ORDER OF: PENDLETON, IN 46064

CHECK AMOUNT

\$760.00

EXACTLY ******760 DOLLARS AND 00 CENTS

Authorized Signature

JPMorgan Chase Bank, N.A. Chicago, IL