

4703

9378 S 650 WEST, P.O. BOX 59, PENDLETON, IN 46064

21-06175.00

This Agreement made and entered into this 8th day of November 2002 between FALL CREEK REGIONAL WASTE DISTRICT ("District") and CP Morgan ("Applicant") regarding the provision of sanitary sewer service, and the assignment of capacity in, and connection to, the District's facilities for the premises located at Lot #36 9197 W. Reflection Ct

1. The Applicant agrees that all workmanship and materials shall conform to all District ordinances and the District's construction standards. District must accept all work and materials before backfilling and final connection is made to the sewer main. If the District determines that any work or materials will cause all lines and appurtenances in violation to be removed and replaced at the Applicant's expense.

3. The Applicant shall be responsible for all charges, including but not limited to, capacity charges, and tap fees. The failure to pay any rate charge or other charge against the property and/or the termination of service to the property, the cost of which will be borne by Applicant, including, but not limited to, all attorney's fees and collection costs.

5. If there is an available sanitary sewer within three hundred (300) feet of the property line, the property owner shall be required to connect to the District's sanitary sewer system.

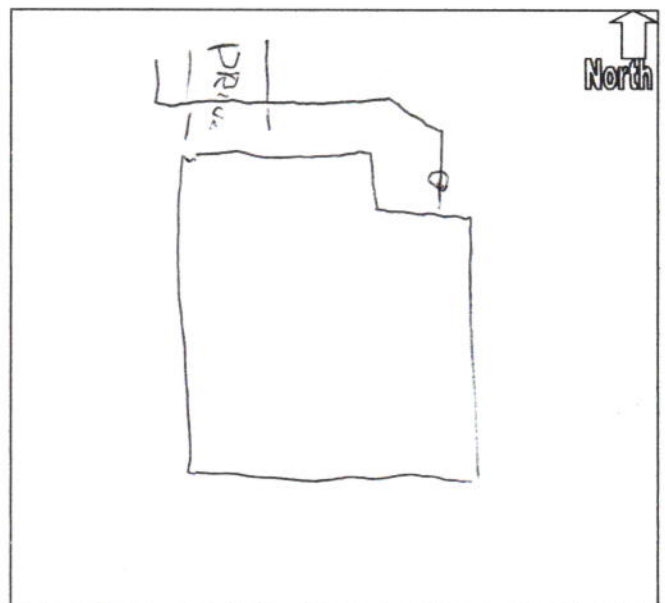
The parties hereto have read and fully understand the above provisions and agree to comply with said provisions.

STATE OF INDIANA)
) SS:
COUNTY OF MADISON)

Signature Jan E. Carey
Printed Jan E. Carey
Notary Public
Resident of Madison County

REASON FOR REJECTION

DATE REINSPECTED APPROVED REJECTED

NEW CONSTRUCTION ☒

25046

C.P. MORGAN COMMUNITIES, LP
CONSTRUCTION ACCOUNT

BANK ONE, NA
INDIANAPOLIS, INDIANA 46277
20-1-740

11/8/2002

PAY TO THE ORDER OF Fall Creek Regional Waste Dist

*****475.00

Four Hundred Seventy-Five and no/100***** DOLLARS

Fall Creek Regional Waste Dist

210036102 SU 36

MEMO

Sonya L. Lewis

MP

⑈025046⑈ ⑆074000010⑆

Details on back
Security Features Included