

Lori Grill
4958

21-06305.00

4958

9th day of September 2003
C.P. Morgan ("App
ent of capacity in, and connection to, the I
e
9212 W. Lodge Lane

9212 W. Lodge Lane

- The parties hereto have read and fully understand the above provisions and agree to comply with said provisions.


APPLICANT Misty Blaylock
Signature

SUBSCRIBED and sworn to before me this 9th day of Sept., 2003.

Signature Jan E. Carey
Printed Jan E. Carey
Notary Public
Resident of Madison County

REASON FOR REJECTION

NEW CONSTRUCTION

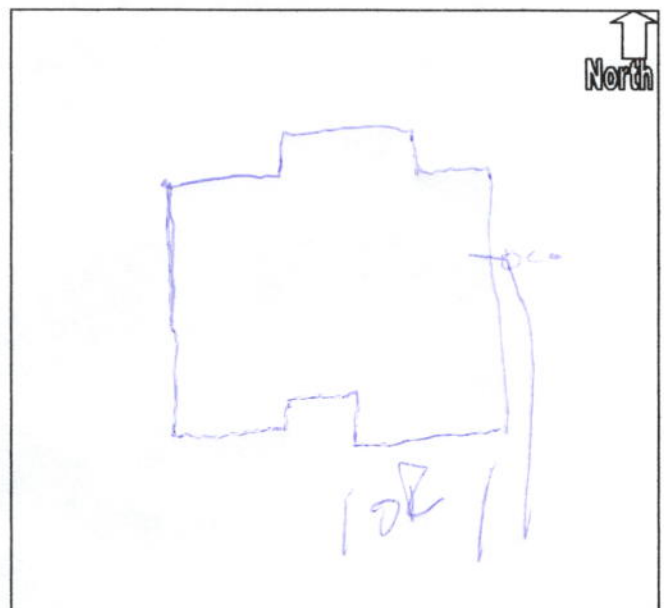

01-00267-10

STATE OF NEW YORK

IN SENATE

JANUARY 10, 1910

REPORT OF THE COMMISSIONERS OF THE LAND OFFICE

IN RESPONSE TO A RESOLUTION PASSED BY THE SENATE

ON JANUARY 10, 1899

ALBANY: J.B. LIPPINCOTT & CO., PRINTERS, 1910.

THE LAND OFFICE OF THE STATE OF NEW YORK

UNDER THE MANAGEMENT OF

THE COMMISSIONER OF LANDS

AND MINES

AND THE ATTORNEY GENERAL

IN RESPONSE TO A RESOLUTION PASSED BY THE SENATE

ON JANUARY 10, 1899

ALBANY: J.B. LIPPINCOTT & CO., PRINTERS, 1910.

THE LAND OFFICE OF THE STATE OF NEW YORK

UNDER THE MANAGEMENT OF

THE COMMISSIONER OF LANDS

AND MINES

AND THE ATTORNEY GENERAL

IN RESPONSE TO A RESOLUTION PASSED BY THE SENATE

29239

C.P. MORGAN COMMUNITIES, LP
CONSTRUCTION ACCOUNT

BANK ONE, NA
INDIANAPOLIS, INDIANA 46277
20-1-740

9-8-03

PAY TO THE
ORDER OF

FALL CREEK REGIONAL WASTEWATER \$ 2635.00

Two Thousand Six Hundred Thirty Five and 00/100 DOLLARS

MEMO

SU 61 Lori Gule

Jorge L. Funes MP

⑈029239⑈ ⑆074000010⑆ 705001387194⑈