


21-06150.00

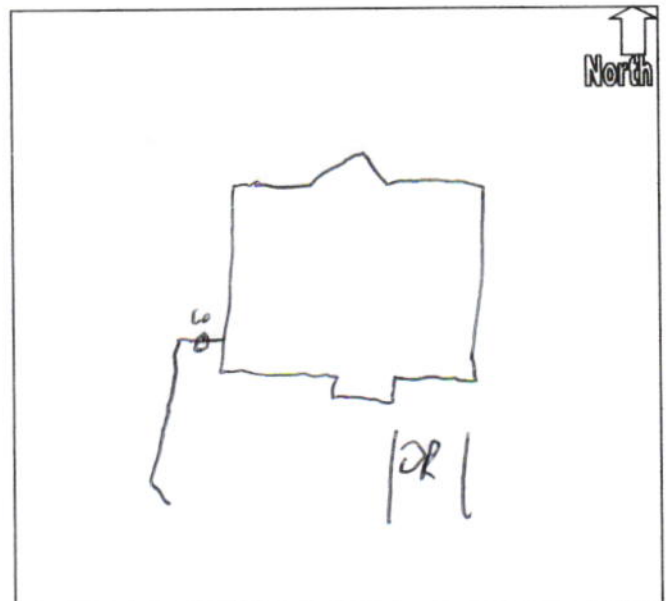

C.P. MORGAN COMMUNITIES, LP
CONSTRUCTION ACCOUNT

BANK ONE, INDIANA, NA
INDIANAPOLIS, INDIANA 46277
20-1-740

23276

9.25

PAY TO THE
ORDER OF

Fall Creek Regional Waste Dist

\$6175.00

Six thousand and one hundred + seventy-five dollars ⁰⁰/₁₀₀ DOLLARS

SU - 85, 31, 80, 143, 96, 148

MEMO (SU - 100, 90, 98, 149, 174, 135, 140, 97

⑈023276⑈ ⑆074000010⑆

Jennifer Hedges MP

Security Features Included Details on back

22960

C.P. MORGAN COMMUNITIES, LP
CONSTRUCTION ACCOUNT

BANK ONE, INDIANA, NA
INDIANAPOLIS, INDIANA 46277
20-1-740

8.30.02

PAY TO THE
ORDER OF

Fall Creek Regional Wastewater

\$ 3325.00

Three thousand three hundred twenty-five dollars & 00/100 DOLLARS

MEMO

SU 35, 37, 76, 47, 69, 53, 73

John A. Bryant

⑈022960⑈ ⑆074000010⑆