#7203

Fall Creek Regional Waste District 9378 S 650 W, P.O. Box 59, Pendleton, IN 46064 765-778-7544 Agreement for Sanitary Sewer Service

This Agreement made and entered into this 10 day of 400, 20 dd, between Fall Creek	
Regional Waste District ("District") and LENNAR HOMES ("Applicant") regarding the provision of sanitary sewer service, and the assignment of capacity in and connection to, the District's	
facilities for the premises located at _ Springbrook Lot 158	
Street Address: 9269 Casey Rd.	
Now therefore, the parties, in consideration of the mutual promises set out in this Agreement, the	
receipt and sufficiency of which is hereby acknowledged, agree as follows:	
 The Applicant agrees that all workmanship and materials shall conform to all District ordinances and the District's construction standards. District must accept and approve all work and materials before backfilling and final connection is made to the sewer mains. Any violation of this provision will cause all lines and appurtenances in violation to be removed and replaced at the Applicant's expense. The District shall have the right to enter upon the Applicant's premises at all reasonable times to inspect, repair, or replace any equipment used in connection with the District's service or which has an impact on said service. The Applicant shall be responsible for all monthly user rates, capacity charges, and tap fees. The failure to pay any rate charge or fee may result in a lien against the property and/or the termination of service to the property, the cost of which will be borne by Applicant, including, but not limited to, all attorney's fees and collection costs. The District shall not be responsible for any damages as a result of any failure to supply service unless said damages are due to default, neglect or culpability on the part of the District. If there is an available sanitary sewer within three hundred (300) feet of the property line, the property owner shall be required to connect to the District's sanitary sewer system. The Applicant and District agree that the provision of sanitary sewer service touches and concerns the property and the terms of this Agreement bind the District and Applicant and their heirs, executors, administrators, personal representatives, successors, agents, attorneys, assigns, designees, and transferees. 	
The parties hereto have read and fully understand the above provisions.	ve provisions and agree to comply with said
FAIL CREEK REGIONAL WASTE DISTRICT	APPLICANT
Signature	Signature
STATE OF INDIANA)) SS: COUNTY OF MADISON)	
SUBSCRIBED and sworn to before me this W day of Warch, 20 A	
My Commission Expires: SEAL Signature Public &	
RACHEL ELAINE ANDERSON	
NOTARY PUBLIC-STATE OF INDIANA Printed	lockel E. Anderson
	otary Public
Resident of <u>Wallan</u> County	
Inspector Date Inspected 6-10-21 Approved Rejected	
Reason for Rejecton	
Date Reinspected Approved	Rejected
Notes: Type Pipe Pvc 35	
Basement Yes No	\(\tau_{\text{No.11}}\)
Sump Pump <u>Yes</u> No	North
Downspout to Ground Yes No	
Septic Tank Pumped & Filled <u>Yes No</u> Contractor DALDWILLEX	Drawing
Special Conditions	
Existing Home	+
New Construction	1 Dictive
	T 511 /1 x F

NO COMMA E SECONDE 29. 200

STOEPPELWERTH

JOB ID SPRINGBK3.158

CONTROL# 96645 LEN

PARCEL#48-15-28-401-005.039-014

9269 CASEY ROAD PENDLETON, IN 46064



1" = 30'

LOT AREA: 8.710 Sq. Ft.

> M.F.F.E.=863.3 M.F.P.G.=863.3

LEGEND: XX.XAB

PROPOSED GRADE PER PLAN

AS BUILT GRADE

S.S.D. ASL PSL W W

- SUB-SURFACE DRAIN SUB-SURFACE DRAIN
SANITARY SEWER
6" AS BUILT SANITARY LATERAL
6" PROPOSED SANITARY LATERAL
STORM SEWER 3/4" WATER CONNECTION WATER MAIN

SWALE

SANITARY MANHOLE

STORM MANHOLE CURB INLET

FIRE HYDRANT

STREET TREE



EMERGENCY FLOOD ROUTE

D.U.&S.S.E. D.&U.E. D.E.&P.E.

DRAINAGE, UTILITY & SANITARY SEWER EASEMENT DRAINAGE & UTILITY EASEMENT DRAINAGE EASEMENT & PEDESTRIAN EASEMENT

B.L. M.F.F.E. M.F.P.G. BUILDING LINE MINIMUM FINISHED FLOOR ELEVATION
MINIMUM FLOOD PROTECTION
GRADE


No. STATE OF SURVENIENT SURVENIEN

David J NOTE: THIS DRAWING IS NOT INTENDED TO BE REPRESENTED AS A RETRACEMENT OR ORIGINAL BOUNDARY SURVEY, A ROUTE SURVEY OR A SURVEYOR LOCATION REPORT.

03/02/21 CRV

7965 East 106th Street, Fishers, IN 46038-2505 phone: 317.849.5935 fax: 317.849.5942

8'PATH

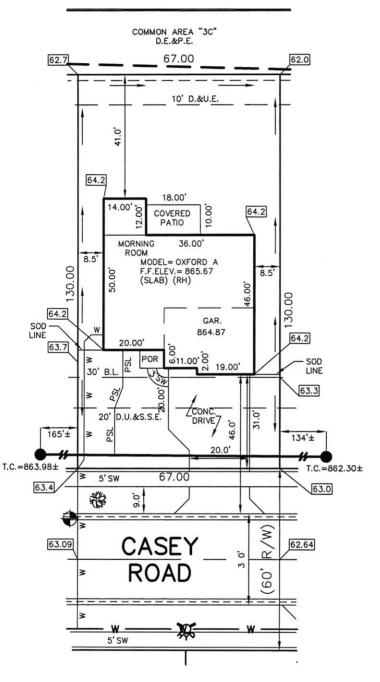

ALL UNDERGROUND SEWERS AND UTILITIES SHOWN ARE PLOTTED BY SCALE FROM DESIGN PLANS FURNISHED BY ENGINEER THE ACTUAL FIELD LOCATION MAY VARY.

LOT 158 SPRINGBROOK SECTION 3

INST. #2020R017818 ZONING: R3

5' MINIMUM SIDE YARD 30' MINIMUM FRONT YARD

15' MINIMUM REAR YARD


BENCHMARK TOP OF CURB=863.09

SOD: SEEDING: SEED IN EASEMENT: CONC. DRIVEWAY: PRIVATE WALK:
PUBLIC WALK:
APRON:
ADDITIONAL SOD TO:
REAR EASEMENT
HANDICAP RAMPS: 212 ± Sq. Yd. 3,917 ± Sq. Ft. 670 ± Sq. Ft. 810 ± Sq. Ft. 24 ± Sq. Ft. 235 ± Sq. Ft. 305 ± Sq. Ft. 361 ± Sq. Yd.

SIGNATURE: DATE:

SIGNATURE REPRESENTS CONFIRMATION OF RECEIPT OF PLOT PLAN BY CUSTOMER

0

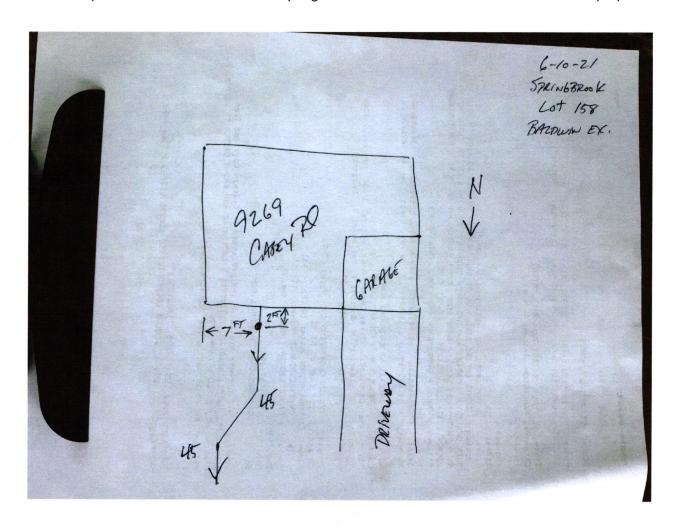



DO NOT ACCEPT THIS CHECK UNLESS YOU CAN SEE A DUAL-TONE TRUE WATERMARK THAT APPEARS AS A CHAIN LINK PATTERN WHEN HELD TO THE LIGHT. 🗈 Lennar Homes of Indiana Inc JPMorgan Chase Bank N.A. 11555 N Meridian St Ste 400 01581360 Chicago, IL 70-2322 719 Carmel, IN 46032 Void if over 180 days DATE AMOUNT PAY 03/08/21 \$*****760.00 DOLLARS

TO THE

Fall Creek Regional Waste District

ORDER

PO Box 59

OF Pendleton IN 46064

Lyane Bessette

THE FACE OF THIS CHECK HAS A BLUE AND GREEN BACKGROUND - ANY OTHER COLORS MAY BE EVIDENCE OF CHEMICAL ALTERATION OR ERASURE - SEE REVERSE SIDE FOR MORE SAFETY FE TURES.

1/00 \$ 011000