



## FALL CREEK REGIONAL WASTE DISTRICT

Box 44, Pendleton, Indiana 46064

3-0715640.00

Nº 000063

## APPLICATION FOR SEWER PERMIT

Permit No. \_\_\_\_\_ Date 8-2-85  
 Permit Void 90 days from Date of Issuance  
 Owner Name MRS. Cecil Kuhns  
 Property Address R2 938 S. Broadway  
 Lot # \_\_\_\_\_ P.O. Box PO Box 132  
 Town Pendleton, IN Zip Code 46064-9570  
 Phone 778-3279 Water Meter no  
 \$ 150.00 Tap on Fee Paid  
 \$ 25.00 Inspection fee paid

Application is hereby made for connection to the Fall Creek Regional Waste District Sewer System for the above listed property - Permit Type: Residential ☒, Commercial \_\_\_\_\_, Industrial \_\_\_\_\_, or Governmental/Institutional \_\_\_\_\_. User Information \_\_\_\_\_.

All workmanship and materials shall conform to the standards of the District Ordinance as described in Ordinance 84-2 and 84-3 as amended. Acceptance and approval must be made by the District inspector or his duly authorized representative before backfilling and final connection is made to the main sewer lines. Any violation of applicable regulations will cause all lines and appurtenances in violation to be removed and replaced at the owners expense.

The Fall Creek Regional Waste District is responsible for the inspection, approval of materials, and installation techniques only. All costs for materials and installation and any liabilities resulting from same is the sole responsibility of the property owner.

I have read and fully understand the above provisions and agree to comply by said provisions.


Mrs Cecil Kuhns Alfred E Benicker  
 APPLICANT(S) SIGNATURE

\*\*\*\*\*

INSPECTOR [Signature]  
 Date inspected 8-2-85 Approved \_\_\_\_\_ Rejected \_\_\_\_\_  
 Reason for rejection \_\_\_\_\_

Date reinspected \_\_\_\_\_ Approved \_\_\_\_\_ Rejected \_\_\_\_\_

Notes:  
 Size Pipe 6"  
 Type Pipe PVC  
 Basement Yes \_\_\_\_\_ No ☒  
 Sump Pump Yes \_\_\_\_\_ No ☒  
 Downspout to Ground Yes ☒ No \_\_\_\_\_  
 Septic Tank Pumped & filled Yes WILL BE No \_\_\_\_\_  
 Contractor ZANDRO  
 Special Conditions LEFT 25' OF EXISTING 4" TILE

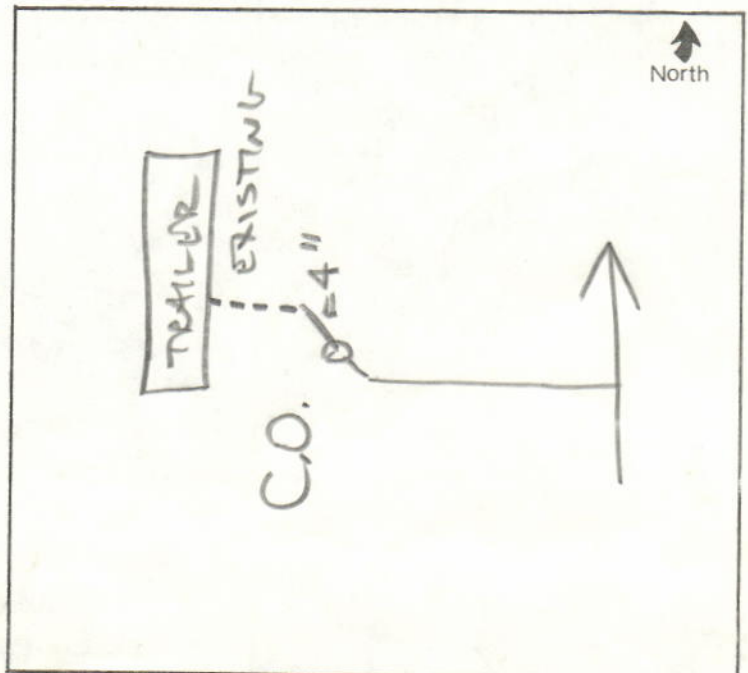



FALL CREEK REGIONAL WASTE DISTRICT

9378 S. 650 West PO Box 59  
Pendleton, IN 46064-0059 778-7544

No 2989

APPLICATION FOR SEWER PERMIT

Date 12-27-00

Permit Void 90 days from Date of Issuance

Owner Name LANDIS EVANS

Property Address 928 S. BROADWAY

Lot # P.O. Box

Town Pendleton, IN Zip Code 46064

Phone City Water Well

\$ NA Tap on Fee Paid REINSTALL lateral

\$ Inspection fee paid

Application is hereby made for connection to the Fall Creek Regional Waste District Sewer System for the above listed property - Permit Type: Residential [checked], Commercial, Industrial, or Governmental/Institutional. User Information

All workmanship and materials shall conform to the standards of the District Ordinance as described in Ordinance 84-2 and 84-3 as amended. Acceptance and approval must be made by the District inspector or his duly authorized representative before backfilling and final connection is made to the main sewer lines. Any violation of applicable regulations will cause all lines and appurtenances in violation to be removed and replaced at the owners expense.

The Fall Creek Regional Waste District is responsible for the inspection, approval of materials, and installation techniques only. All costs for materials and installation and any liabilities resulting from same is the sole responsibility of the property owner.

I have read and fully understand the above provisions and agree to comply by said provisions.

APPLICANT(S) SIGNATURE

INSPECTOR [Signature]

Date inspected 12-27-00 Approved [checked] Rejected

Reason for rejection

Date reinspected Approved Rejected

Notes:  
Size Pipe 6"  
Type Pipe PVC  
Basement Yes No [checked]  
Sump Pump Yes No [checked]  
Downspout to Ground Yes [checked] No  
Septic Tank Pumped & filled Yes No [checked]  
Contractor  
Special Conditions  
Existing Home [checked] New Double wide  
New Construction

