



FALL CREEK REGIONAL WASTE DISTRICT

9378 S. 650 West PO Box 59
Pendleton, IN 46064-0059 778-7544

add order
on file

21-99999.00

APPLICATION FOR SEWER PERMIT

Nº 2669

Date 3/5/99

Permit Void 90 days from Date of Issuance

Owner Name Pendleton Juvenile Correctional Facility

Property Address 9310 S SR 67

Lot # _____ P.O. Box _____

Town Pendleton, IN Zip Code 46064

Phone _____ City Water _____ Well ☒

\$ 400.00 Tap on Fee Paid

\$ 243,019.35 Capacity ~~Inspection~~ fee paid

Application is hereby made for connection to the Fall Creek Regional Waste District Sewer System for the above listed property - Permit Type: Residential _____, Commercial _____, Industrial _____, or Governmental/Institutional ☒. User Information _____.

All workmanship and materials shall conform to the standards of the District Ordinance as described in Ordinance 84-2 and 84-3 as amended. Acceptance and approval must be made by the District inspector or his duly authorized representative before backfilling and final connection is made to the main sewer lines. Any violation of applicable regulations will cause all lines and appurtenances in violation to be removed and replaced at the owners expense.

The Fall Creek Regional Waste District is responsible for the inspection, approval of materials, and installation techniques only. All costs for materials and installation and any liabilities resulting from same is the sole responsibility of the property owner.

I have read and fully understand the above provisions and agree to comply by said provisions.

APPLICANT(S) SIGNATURE _____

INSPECTOR TIM

Date inspected 11-10-99 Approved ☒ Rejected _____

Reason for rejection _____

Date reinspected _____ Approved _____ Rejected _____

Notes:
Size Pipe 8"

Type Pipe SDR 35

Basement Yes _____ No ☒

Sump Pump Yes _____ No ☒

Downspout to Ground Yes ☒ No _____


Septic Tank Pumped & filled Yes _____ No _____

Contractor KREGER Brothers

Special Conditions _____

Existing Home _____

New Construction ☒

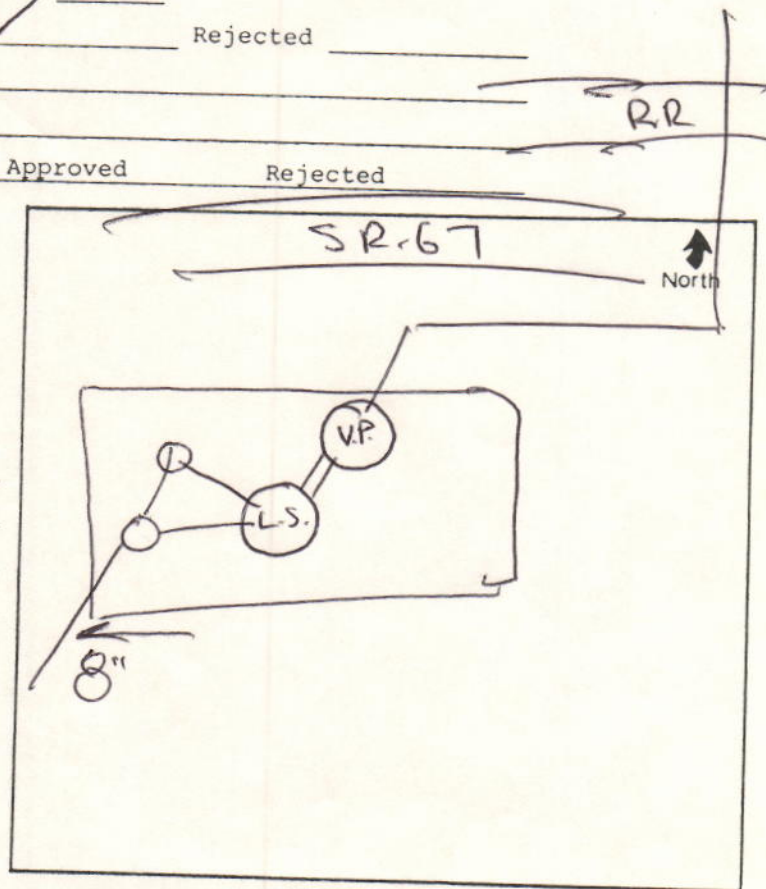

BOSE McKINNEY & EVANS

ATTORNEYS AT LAW

LEWIS C. BOSE
ROBERT P. KASSING
G. PEARSON SMITH, JR.
DAVID A. BUTCHER
PHILIP A. NICELY
THEODORE J. NOWACKI
KENDALL C. CROOK
RONALD E. ELBERGER
DAVID L. WILLS
CHARLES R. RUBRIGHT
DANIEL C. EMERSON
ALAN W. BECKER
DANIEL B. SEITZ
DAVID A. TRAVELSTEAD
MARGARET BANNON MILLER
RONALD M. SOSKIN
GEORGE E. PURDY
KEITH E. WHITE
L. PARVIN PRICE
DAVID L. SWIDER
JAMES C. CARLINO

R.J. McCONNELL
C. JOSEPH RUSSELL
JON M. BAILEY
ELIZABETH THEOBALD YOUNG
MICHAEL A. TRENTADUE
KARL R. STURBAUM
ROBERT B. CLEMENS
KATHLEEN G. LUCAS
RODERICK H. MORGAN
DWIGHT L. MILLER
V. SAMUEL LAURIN, III
E. VICTOR INDIANO
JAMES E. CARLBERG
GEORGE T. PATTON, JR.
DEBRA L. BURNS
GARY L. CHAPMAN
ROBERT K. JOHNSON
JAMES A. COLES
DONALD M. MEYER
DANIEL P. MCINERNEY
KIRK E. GRABLE

THOMAS E. WHEELER, II
STEVEN G. RUDOLF
NATALIE J. STUCKY
TAMMY K. HANEY
SUSAN E. TRAYNOR
KAREN GLASSER SHARP
LISA MCKINNEY GOLDNER
ALAN S. TOWNSEND
MARY BETH PLUMMER
J. CHRISTOPHER JANAK
AMY RANKIN KENNELLY
CATHY ELLIOTT
J. GREGORY SHELLEY
JEFFREY M. REED
JEFFREY A. HOKANSON
STEPHANIE F. HOLTZLANDER
ANDREW M. MCNEIL
MONIQUE C. WINKLER
J. TAGGART BIRGE
KATHLEEN I. LEE
ANTHONY P. FILOMENA

BERNIE W. KELLER
APRIL EDWARDS SELLERS
JOHN A. MILLSPAUGH

OF COUNSEL
PETER L. GOERGES
ARTHUR W. DEPREZ
DIANE MARGER MOORE
RONALD K. AUST
RODGER K. HENDERSHOT
JUDY L. WOODS
PHYLLIS J. GARRISON

RETIRED FROM THE PARTNERSHIP
ROBERT H. MCKINNEY
WAYNE C. PONADER
JAMES P. SEIDENSTICKER, JR.
JOHN W. WYNNE
WILLIAM M. EVANS (1923-1991)

March 4, 1999

VIA UPS NEXT DAY AIR

Mr. Joe Rowlett
General Manager
Fall Creek Regional Waste District
9378 South 650 West
Pendleton, IN 46064


Re: DOC

Dear Joe:

Enclosed please find the check in the amount of \$243,419.35 from the Indiana State Office Building Commission.

If you should have any questions, please do not hesitate to contact me.

Very truly yours,

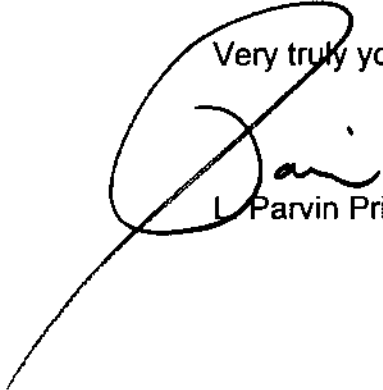
L. Parvin Price

LPP/Imm/Enclosure/220115

INDIANA STATE OFFICE BUILDING COMMISSION
PENDLETON JUVENILE CORRECTIONAL FACILITY

402 W. WASHINGTON STREET, ROOM W478
INDIANAPOLIS, IN 46204-2744

NBD BANK, N.A.
INDIANA CENTRAL REGION
INDIANAPOLIS, INDIANA 46266
20-5-740

001094

1094

\$TWO HUNDRED FORTY THREE THOUSAND FOUR HUNDRED NINETEEN AND 35 CENTS

DATE 03/02/99 AMOUNT ***243,419.35*

PAY
TO THE
ORDER
OF

Fall Creek Regional Waste Dis
9378 S. 650 West
PO Box 59
Pendleton

IN 46064-0059

⑈001094⑈ ⑆074000052⑆

David Williams