#7665

Fall Creek Regional Waste District 9378 S 650 W, P.O. Box 59, Pendleton, IN 46064 765-778-7544

Agreement for Sanitary Sewer Service

This Agreement made and entered into this day of Regional Waste District ("District") and Lennar Homes provision of sanitary sewer service, and the assignment of capacifacilities for the premises located at Springbrook Lot 246	("Applicant") regarding the
Street Address: 9343 Casey Rd.	
Now therefore, the parties, in consideration of the mutual promises set out in this Agreement, the receipt and sufficiency of which is hereby acknowledged, agree as follows:	
 The Applicant agrees that all workmanship and materials shall conform to all District ordinances and the District's construction standards. District must accept and approve all work and materials before backfilling and final connection is made to the sewer mains. Any violation of this provision will cause all lines and appurtenances in violation to be removed and replaced at the Applicant's expense. The District shall have the right to enter upon the Applicant's premises at all reasonable times to inspect, repair, or replace any equipment used in connection with the District's service or which has an impact on said service. The Applicant shall be responsible for all monthly user rates, capacity charges, and tap fees. The failure to pay any rate charge or fee may result in a lien against the property and/or the termination of service to the property, the cost of which will be borne by Applicant, including, but not limited to, all attorney's fees and collection costs. The District shall not be responsible for any damages as a result of any failure to supply service unless said damages are due to default, neglect or culpability on the part of the District. If there is an available sanitary sewer within three hundred (300) feet of the property line, the property owner shall be required to connect to the District's sanitary sewer system. The Applicant and District agree that the provision of sanitary sewer service touches and concerns the property and the terms of this Agreement bind the District and Applicant and their heirs, executors, administrators, personal representatives, successors, agents, attorneys, assigns, designees, and transferees. 	
The parties hereto have read and fully understand the above provisions and agree to comply with said provisions. FAL CREEK REGIONAL WASTE DISTRICT Signature APPLICANT Signature	
STATE OF INDIANA)	2.g
) SS: COUNTY OF MADISON)	
SUBSCRIBED and sworn to before me this day of	, 20
My Commission Expires: Signature_	,
Printed	
Notary Public	
*******************	esident of County *******
Inspector Date Inspected 5-13-22 Approved_ Reason for Rejecton	Rejected
Date Reinspected Approved	Rejected
Notes: Size Pipe V 35	
Basement Yes No	
Sump Pump <u>Yes No</u>	North
Downspout to Ground Yes No	
Septic Tank Pumped & Filled <u>Yes No</u> Contractor DR WATSON	
Special Conditions	Drawing
Existing Home	
New Construction	1

STOEPPELWERTH

7965 East 106th Street, Fishers, IN 46038-2505 phone: 317.849.5935 fax: 317.849.5942

CONTROL# 102974 LEN

JOB ID SPRINGBK5.246

PARCEL#48-15-28-401-001.036-014

9343 CASEY ROAD PENDLETON, IN 46064



1" = 30'

LOT AREA: 8,710 Sq. Ft.

> M.F.F.E.=863.3 M.F.P.G.=862.7

XX.X

PROPOSED GRADE PER PLAN

AS BUILT GRADE XX.XAB

PSL W

S.S.D.

- SUB-SURFACE DRAIN SANITARY SEWER

6" AS BUILT SANITARY LATERAL 6" PROPOSED SANITARY LATERAL STORM SEWER 3/4" WATER CONNECTION WATER MAIN

SWALE

SANITARY MANHOLE

STORM MANHOLE

CURB INLET FIRE HYDRANT

STREET TREE

D.U.&S.S.E.


D.E. D.&U.E. B.L. P.E. M.F.F.E.

M.F.P.G.

DRAINAGE, UTILITY & SANITARY SEWER EASEMENT DRAINAGE & UTILITY EASEMENT DRAINAGE & UTILITY EASEMENT

BUILDING LINE PEDESTRIAN EASEMENT MINIMUM FINISHED FLOOR ELEVATION
MINIMUM FLOOD PROTECTION

COMMON AREA 5A D.E.&P.E. 61.1 T.C.=860.70± 67.00 10' <u>D.&U</u>.E. 44.0, 16.00 8 18.67 ,00 12.00 PATIO 62.9 62.9 00 00 18.33 MODEL= EVERETT E F.F.ELEV.= 864.37 (SLAB) (RH) 130.0 30. 40. 9.5 9.5' GAR 863.57 62.9 SOD .33' 8 62.9 SOD 19.71 61.9 62.3 CONC._ DRIVE 20' D.U.&S.S E. 0 D.S.=5.2% M 67'± 201'± 31.0 PSL 48.6 62.0 61.6 T.C.=862.30±= 67.00 T.C.=862.63 AS BUILT 20.0 9.0, 卷 粉 R/W) **CASEY** 61.25 61.66 ROAD ,09 5' SW

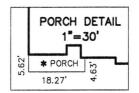

BENCHMARK TOP OF CASTING=862.63

LOT 246 **SPRINGBROOK** SECTION 5


INST. #2021R019149 ZONING: R3 5' MINIMUM SIDE YARD 30' MINIMUM FRONT YARD

15' MINIMUM REAR YARD

ALL UNDERGROUND SEWERS AND UTILITIES SHOWN ARE PLOTTED BY SCALE FROM DESIGN PLANS FURNISHED BY ENGINEER THE ACTUAL FIELD LOCATION MAY VARY.

CONC. DRIVEWAY: PRIVATE WALK: PUBLIC WALK: APRON: ADDITIONAL SOD: HANDICAP RAMPS: 612 ± Sq. Yd. 4,075 ± Sq. Ft. 861 ± Sq. Ft. 22 ± Sq. Ft. 235 ± Sq. Ft. 305 ± Sq. Ft. 453 ± Sq. Yd.


SIGNATURE: SIGNATURE REPRESENTS CONFIRMATION OF RECEIPT OF PLOT PLAN BY CUSTOMER

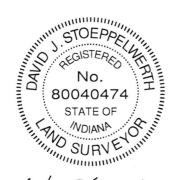

David J. Stoeppelwerth

NOTE: THIS DRAWING IS NOT INTENDED TO BE REPRESENTED AS A RETRACEMENT OR ORIGINAL BOUNDARY SURVEY A ROUTE SURVEY OR A SURVEYOR LOCATION REPORT.



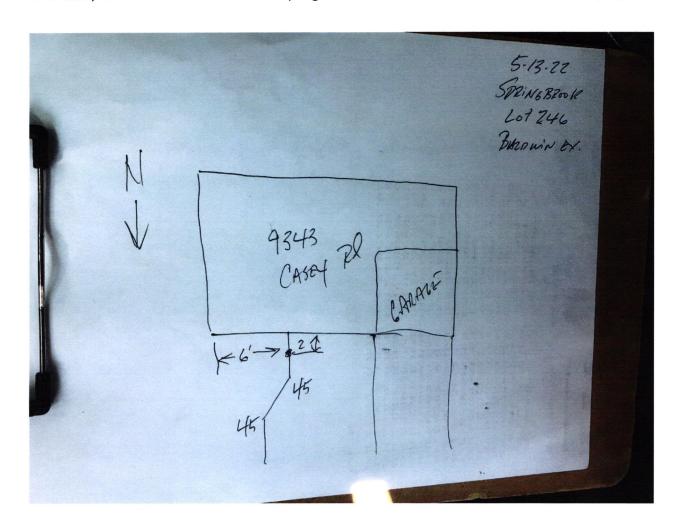



Lennar Corporation Lennar Homes of Indiana, LLC Indianapolis Division 11555 N Meridian St Ste 400 Carmle, IN 46032

CHECK NUMBER

1777917

70-2322 719

March 24, 2022

PAY

FALL CREEK REGIONAL WASTE DISTRICT

TO THE

JPMorgan Chase Bank, N.A. Chicago, IL

PO BOX 59

ORDER OF: PENDLETON, IN 46064

*** VOID AFTER 180 DAYS ***

CHECK AMOUNT

\$760.00

EXACTLY *******760 DOLLARS AND 00 CENTS

Authorized Signature

Rec# 012191